


T.28S. R.14W. W.M.

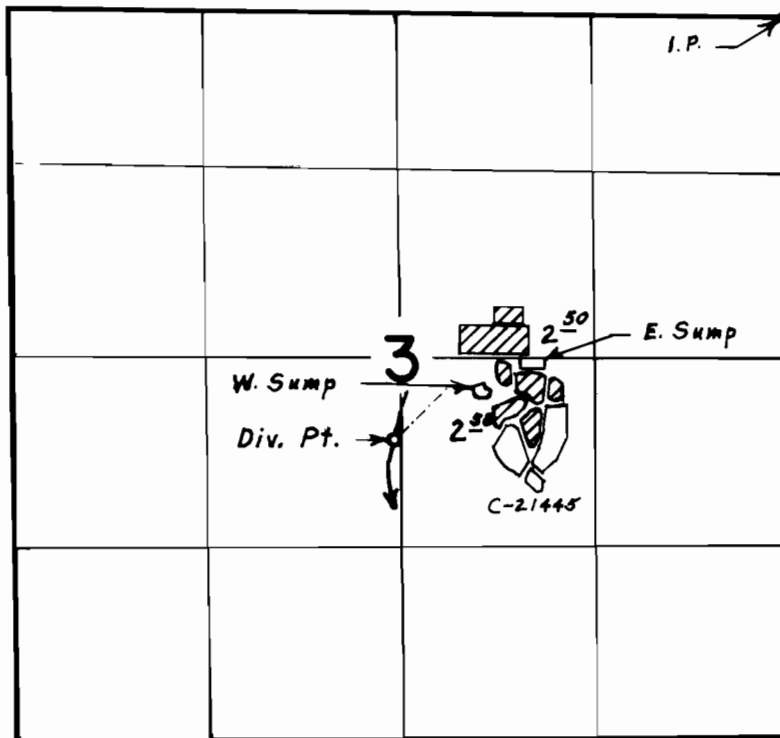

*Div. Pt. located 2900' S. & 2680' W. from N. E. Cor. Sec. 3*

**FINAL PROOF SURVEY**  
UNDER

Application No. 48554. Permit No. 36440.  
IN NAME OF

FERN R. PETERSON

Surveyed July 14, 1976, by L. E. Gould.