


P. 23047

SUP 27449
51878

T.9S. R.21E.W.M.

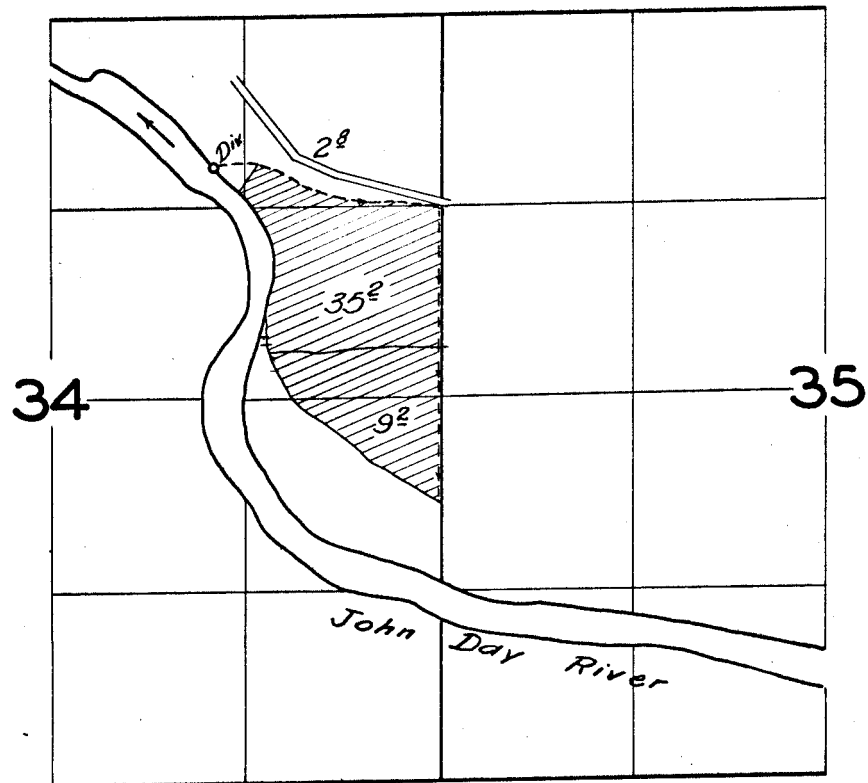

FINAL PROOF SURVEY
UNDER

Application No. 27458.. Permit No. 23047..
IN NAME OF

Surveyed June 24 1959, by CH Bartels

DOV-10H-51