


T. 9S., R. 2W., W.M.

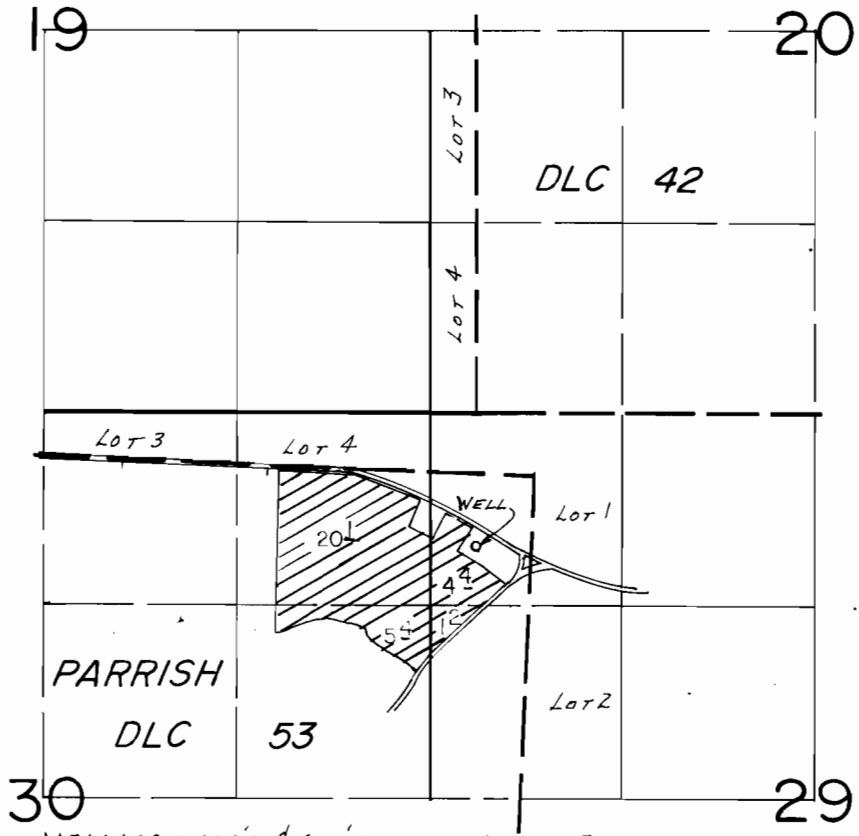

WELL LOC.: 460'S. & 400' W. FROM NE COR. PARRISH DLC 53.

SCALE: 1" = 1320'

FINAL PROOF SURVEY
UNDER

Application No. G-7622, Permit No. G-7067....
IN NAME OF

.....HENRY T. BRAWLEY.....

Surveyed April 24, 1985, by P.R. PAGTER.....