


T. 1 S. R. 24 E. W.M.

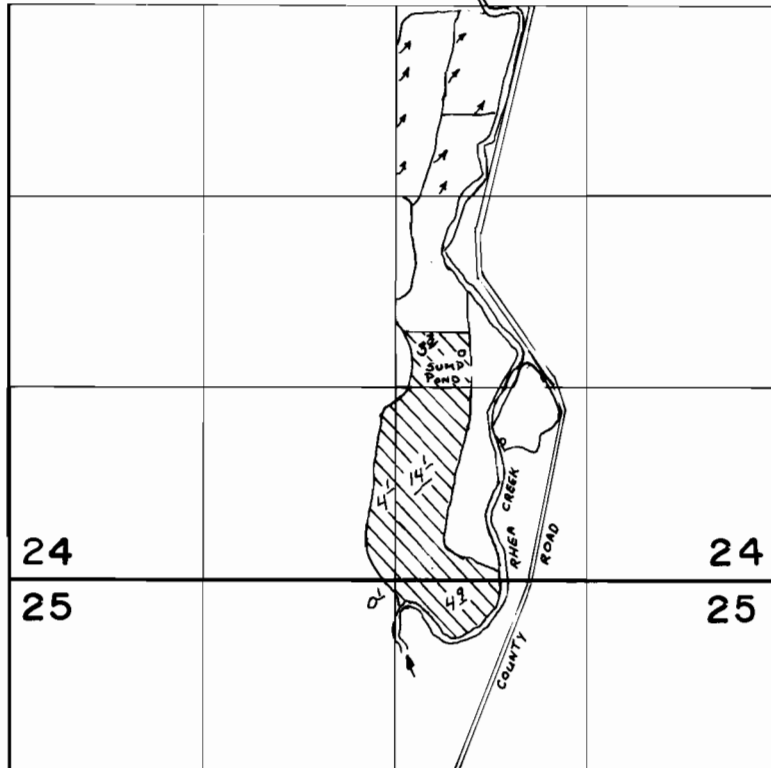

SCALE: 4" = 1 MILE



SUMP POND : 1050' SOUTH AND 450' EAST FROM THE CENTER
SECTION 24.

FINAL PROOF SURVEY UNDER

Application No. ~~G-8080~~ Permit No. ~~G-7546~~.....
IN NAME OF

R. W. BERGSTROM

Surveyed ...~~6-23~~... 1978, by ~~R. BARWIN~~.....
5-1 84 J. K. SAUTER