


Dennis Blonder

G-7844
65077

T. 40 S., R. 23 E., W.M.

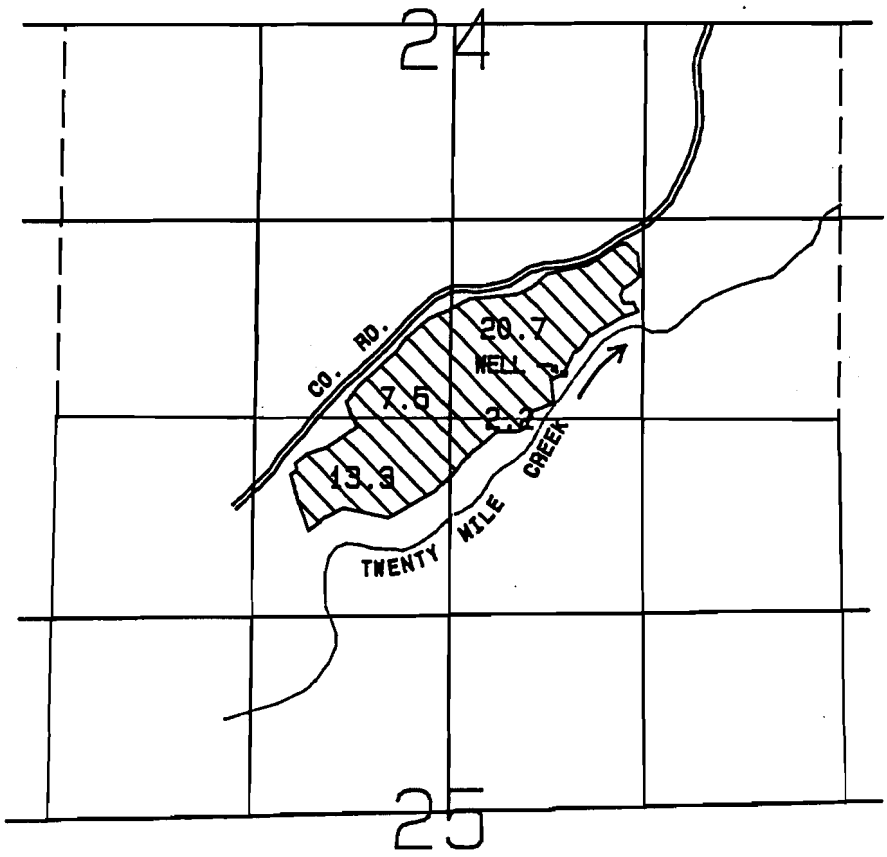

SCALE: 1 = 1320

WELL LOCATED 310 FT. N. AND 1890 FT. W. FROM SE. COR. SEC. 24

FINAL PROOF SURVEY
UNDER

APPLICATION NO. G-8456 PERMIT NO. G-7844
IN NAME OF Cert. # 65077

DONALD C. ROBINSON

Surveyed Oct. 17, 1987 By V.L. CHURCH

Photo: PTS JCL