


T.12S. R.5W. W.M.

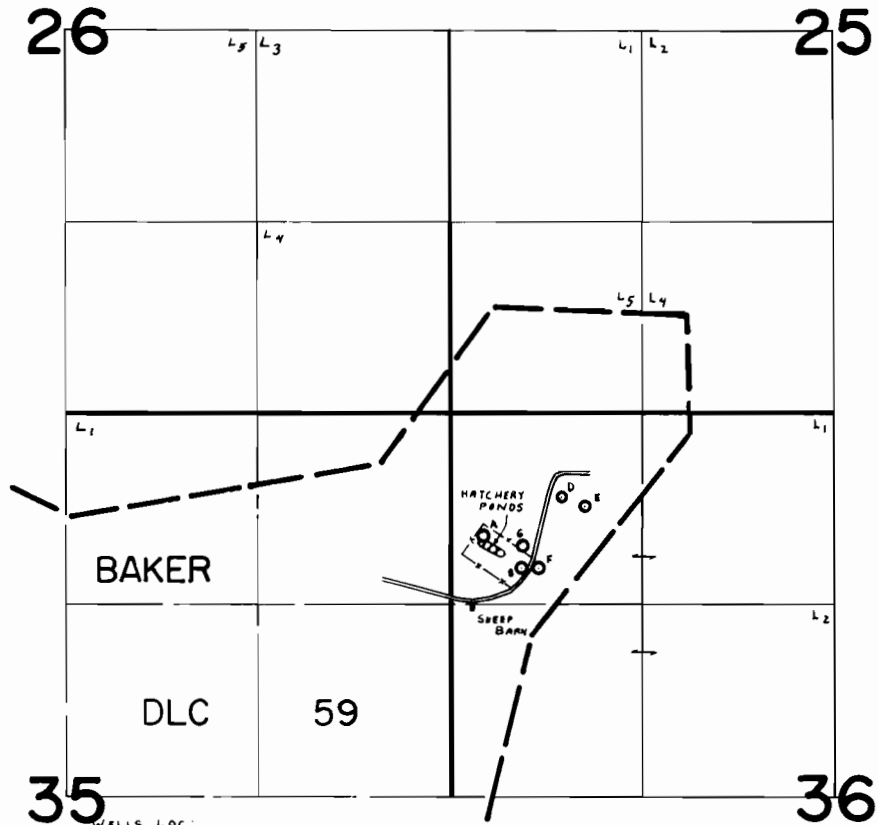

WELLS LOC:
A - 850' S. & 220' E.
B - 1070' S. & 480' E.
D - 580' S. & 770' E.
E - 450' S. & 920' E.
F - 1070' S. & 600' E.
C - 920' S. & 490' E. } ALL FROM N.W. COR. SEC. 36.

FINAL PROOF SURVEY
UNDER

Application No. G-8848 Permit No. G-8217.....
IN NAME OF

JEFFRY ALEXANDER GENGE.....

Surveyed May 28, 1980, by C.L. Hughes.....