


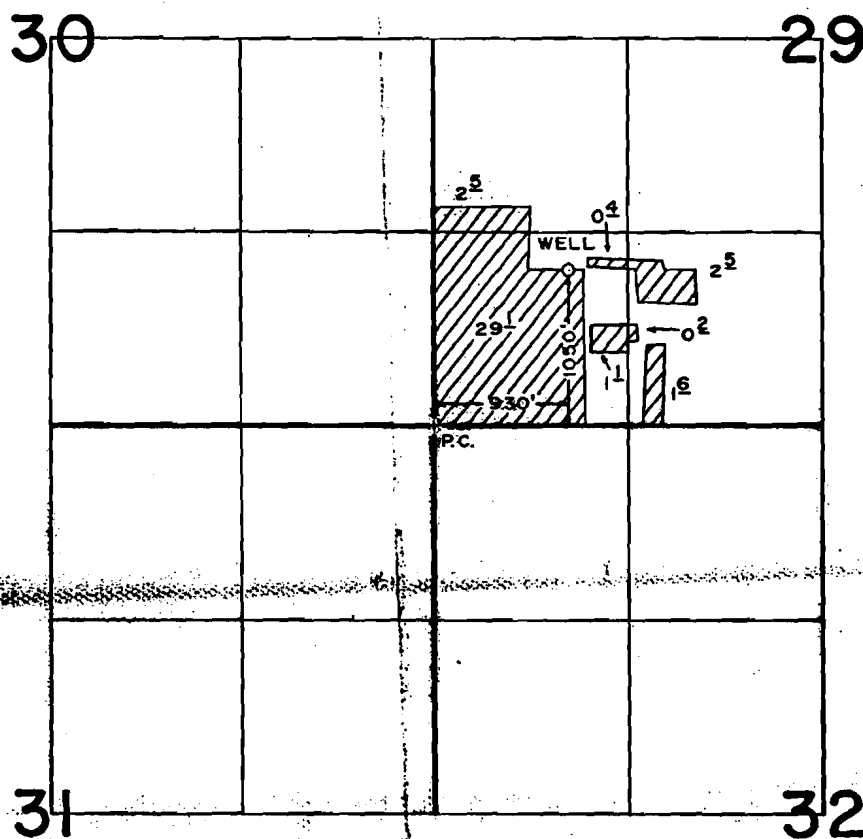

T. 14 S., R. 14 E., W.M.



SCALE: 1" = 1320'

FINAL PROOF SURVEY
UNDER

Application No. G-9527 Permit No. G-8880
IN NAME OF

Cert. 65080

KENNETH W. TAYLOR

Surveyed FEB. 6 1990, by B. W. BISHOP