


G-9073

65081



T. 39 S., R. 19 & 20 E., W.M.

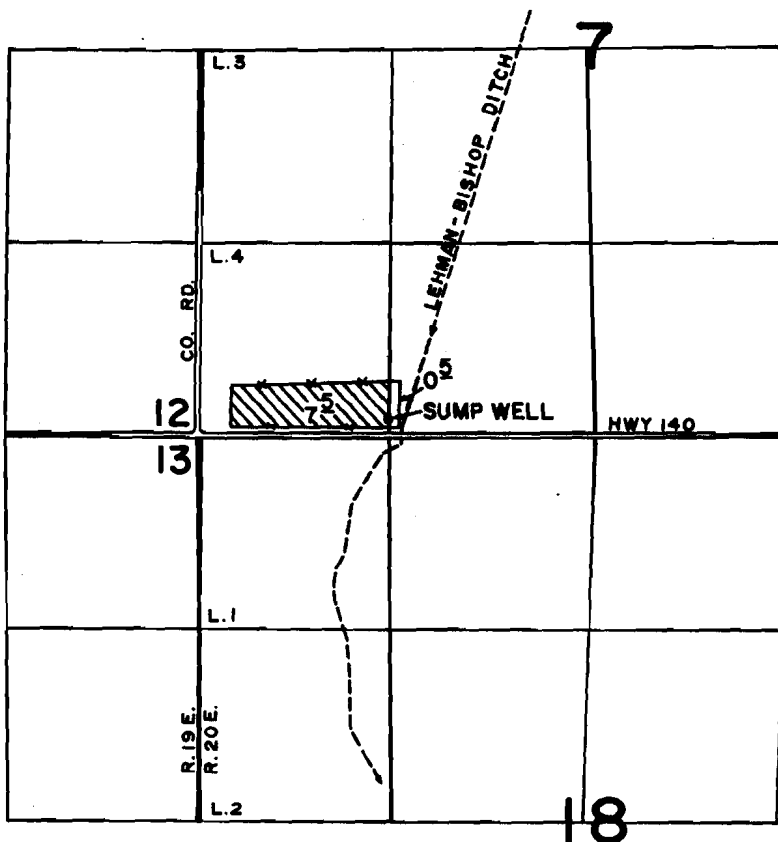

WELL LOCATED: 110' N. & 1300' E. FROM SW CORNER SECTION 7

SCALE: 1" = 1320'

FINAL PROOF SURVEY

UNDER

Application No. G-9890 Permit No. G-9073...
IN NAME OF Cert. # 65081

.....ROBERT A. GOSCH.....

Surveyed OCT. 19. 1987., by V. L. CHURCH...

9-27-90
41037-379-71C