




G-9906

T.2&3N., R.11&12E., W.M.

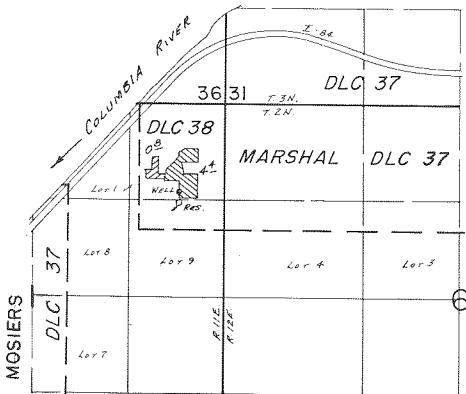

DIV. PT. LOC: 320' N & 500' E, WELL LOC: 520' N & 530' E, BOTH FROM SW CORNER MARSHAL DLC 38

-  Primary from reservoir. Supplemental from well.
-  Primary from well.

FINAL PROOF SURVEY UNDER

G-10809 G-9906
R-64150 R-8516

Application No. 64150. Permit No. 47082...
IN NAME OF

RICHARD J. & JEANE BAILEY

Surveyed NOV. 18, 1987, by V.L. CHURCH...

2/17/88 QMB
41065-379-214