


T.2&3N., R.11&12E., W.M.

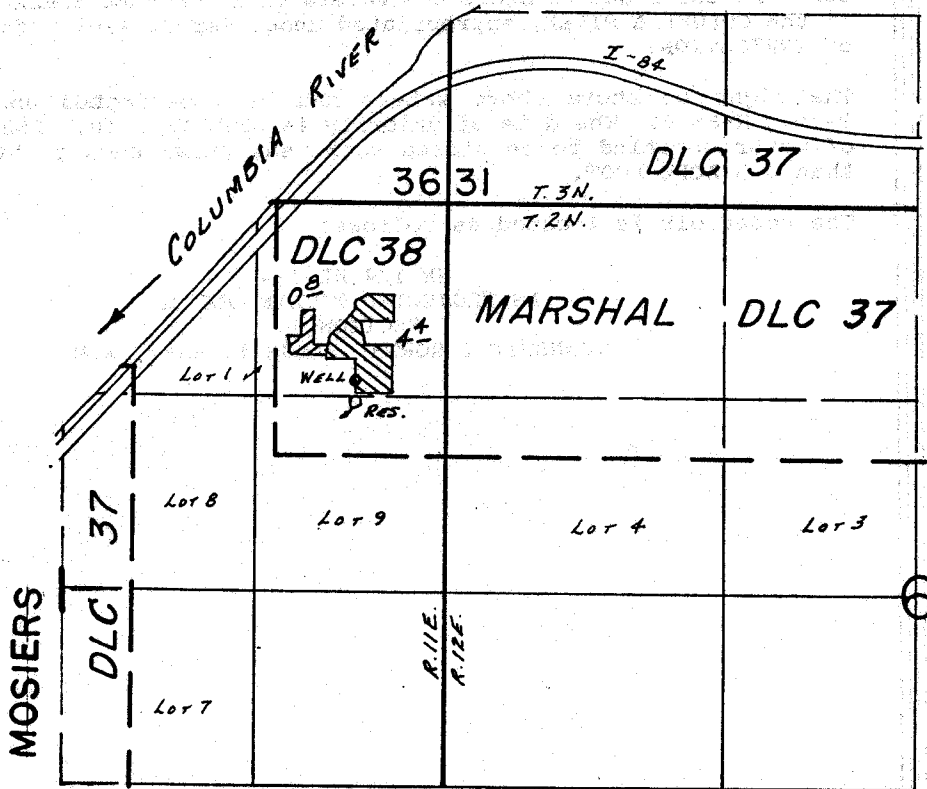

Div. Pt. Loc: 320' N. & 500' E, WELL Loc: 520' N. & 550' E, BOTH FROM SW CORNER MARSHAL DLC 38

- Primary from reservoir. Supplemental from well.
- Primary from well.

FINAL PROOF SURVEY
UNDER

G-10809 G-9906
R-64150 R-8516
Application No. .64.15.1. Permit No. 47.0.8.9....
IN NAME OF

RICHARD J. & JEANE BAILEY.....

Surveyed NOV. 18. 19.87. by V.L. CHURCH.....

2/17/88 RJB
41065-379-214