




T.2&3N., R.11&12E., W.M.

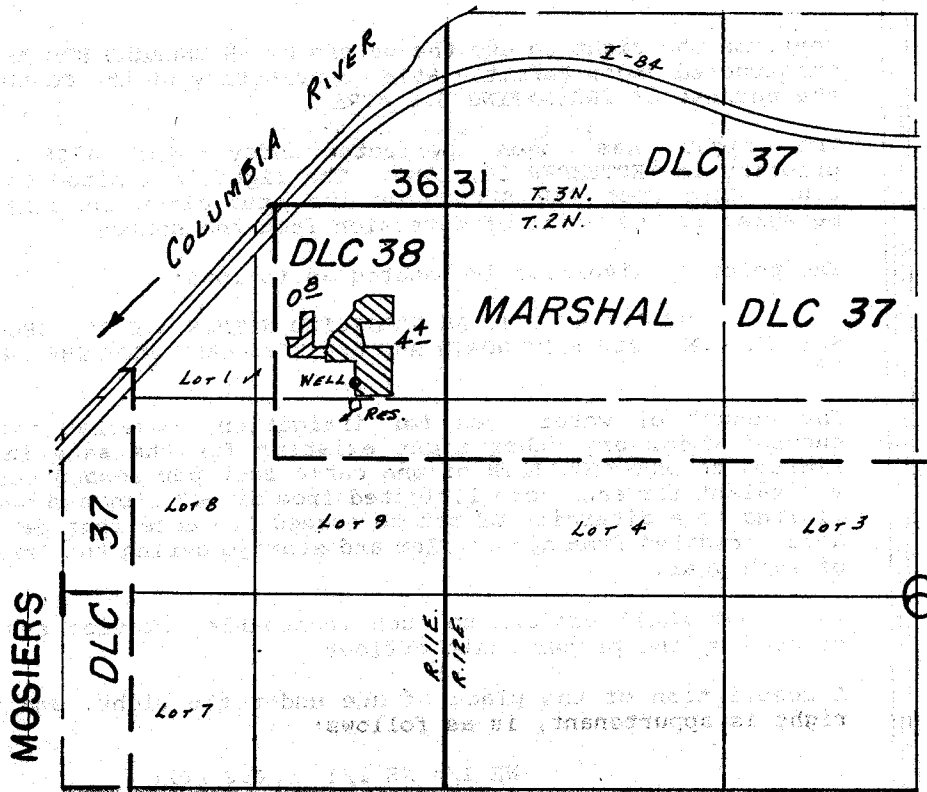

Div. Pt. Loc: 320' N. & 500' E, WELL Loc: 520' N. & 550' E, BOTH FROM SW CORNER MARSHAL DLC 38

-  Primary from reservoir. Supplemental from well.
-  Primary from well.

### FINAL PROOF SURVEY UNDER

Application No. R-64150      Permit No. R-8516

Application No. 64151 Permit No. 47089  
IN NAME OF

RICHARD J. & JEANE BAILEY

Surveyed NOV. 18. 19.87. by V.L. CHURCH