


T.15S., R.12E., W.M.

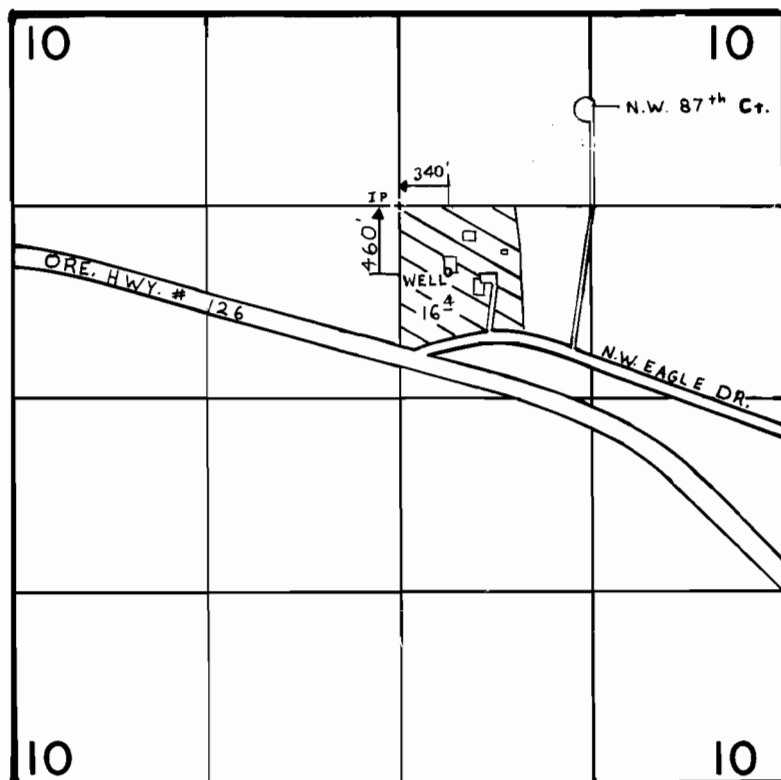

SCALE: 1" = 1320'

FINAL PROOF SURVEY
UNDER

Application No. G-11035 Permit No. G-10201...
IN NAME OF

ANITA M. LIMBECK

Surveyed AUG. 29, 1985, by LESLIE OLSON...