


T.15S.R.10E.W.M.

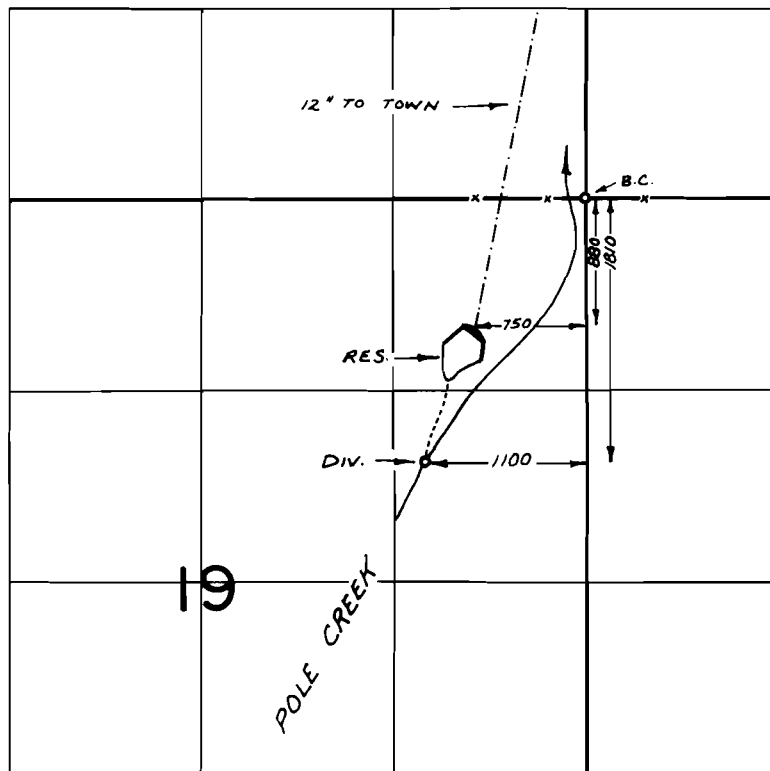

FINAL PROOF SURVEY
UNDER

R-43919 R-5054
Application No. 44263 Permit No. 32054
IN NAME OF

CITY OF SISTERS

Surveyed AUG. 31, 1976, by R. MUGKEN