


T.15S.R.10E.W.M.

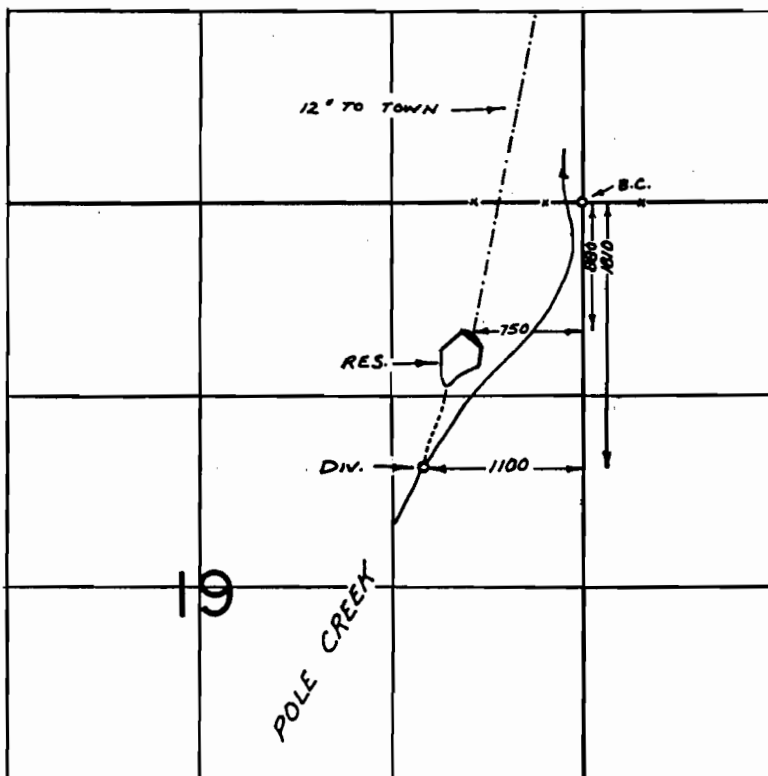

FINAL PROOF SURVEY UNDER

R-43919 R-5054
 Application No. ~~44263~~ Permit No. ~~32054~~
 IN NAME OF

cont. 65090
 cont. 65091

.....CITY OF SISTERS.....

Surveyed AUG. 31, 1976., by R. MUGGEN

Map

32854