


# T. 30S., R. 2W., W.M.

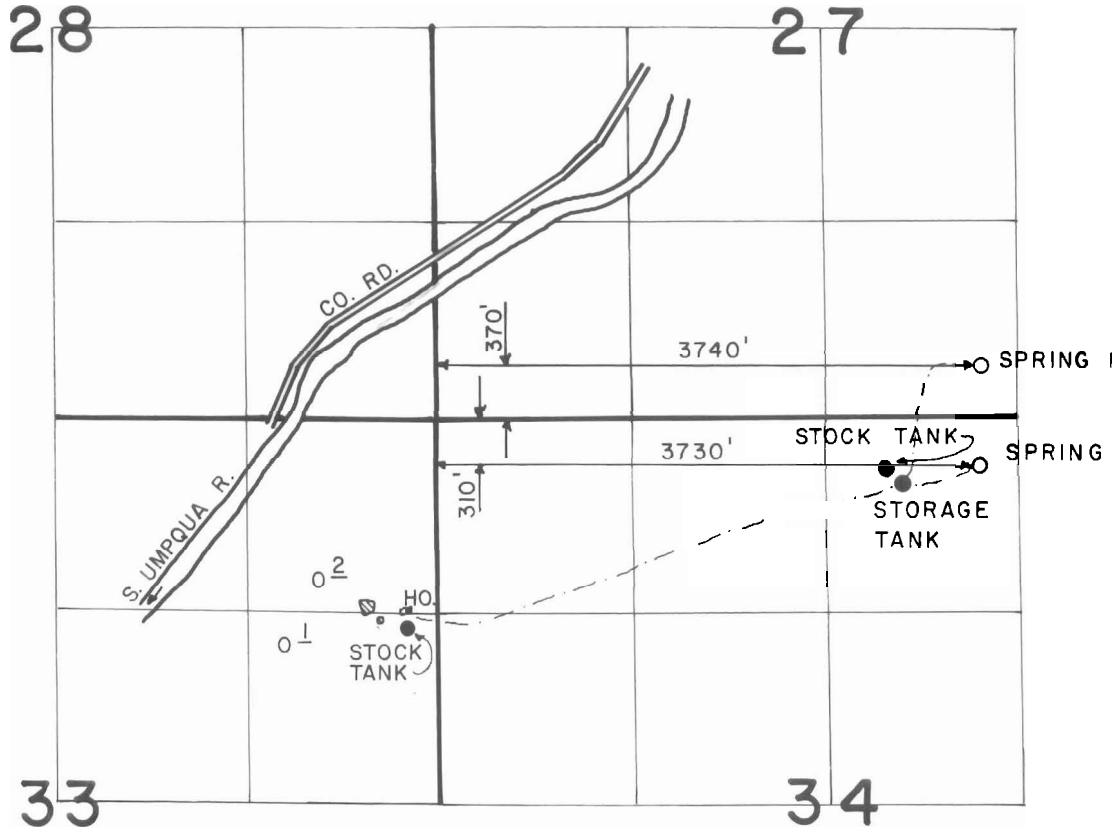

SCALE: 4" = 1 MILE

## FINAL PROOF SURVEY UNDER

Application No. 46114..... Permit No. 34206.....  
IN NAME OF

WILBUR I. HUBBARD & LYDIA F. HUBBARD

Surveyed SEPT. 16 1987, by J. M. SCHMORDE