


P-41361  
65094

T.13S., R.27E., W.M.

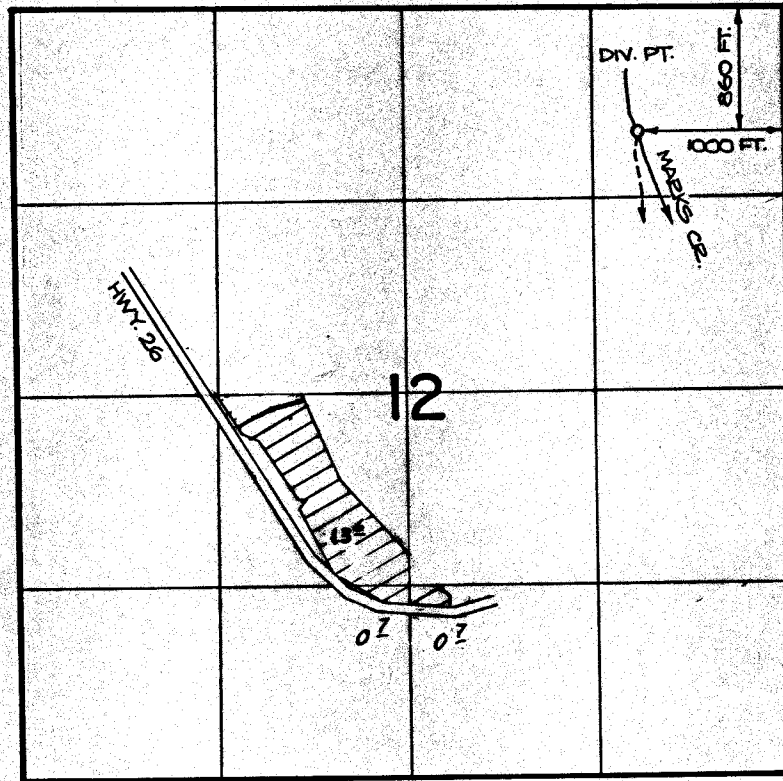

**FINAL PROOF SURVEY**  
UNDER

SCALE: 4" = 1 MILE

Application No. 47032 Permit No. 41361  
IN NAME OF

EDWARD B. UFFELMAN

Surveyed AUG. 9, 1984, by P. P. [Signature]