


T.27 S. R.13 W. W.M.

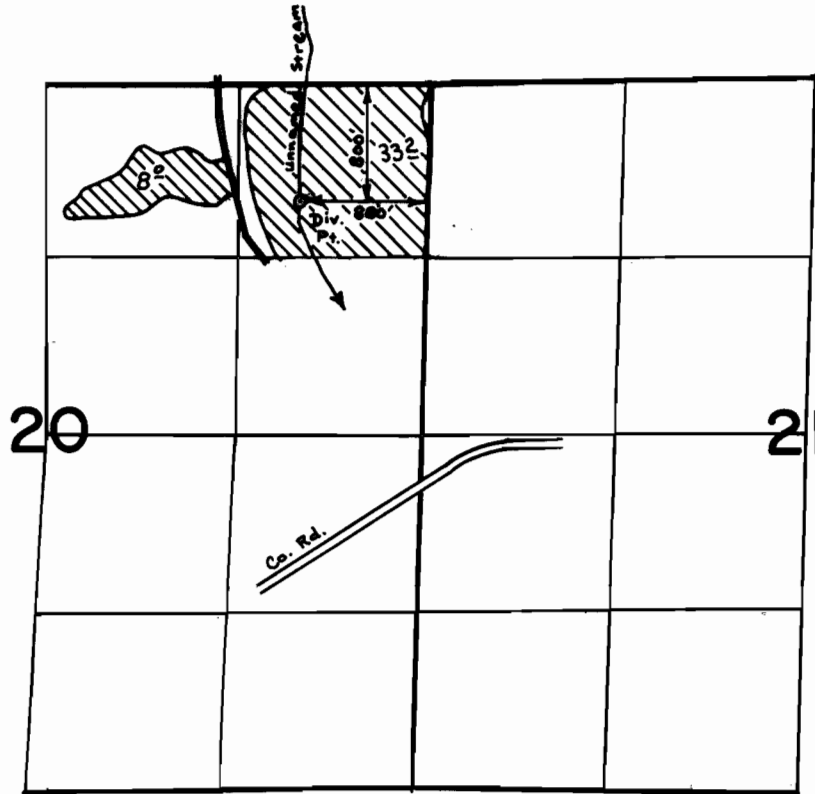

SCALE : 4" = 1 mi.

FINAL PROOF SURVEY
UNDER

Application No. 47509 Permit No. 35583
IN NAME OF

CLIFTON R. BRENIMAN

Surveyed May 15, 1978, by D. Sparks