


T.35 S., R.4 W., W.M.

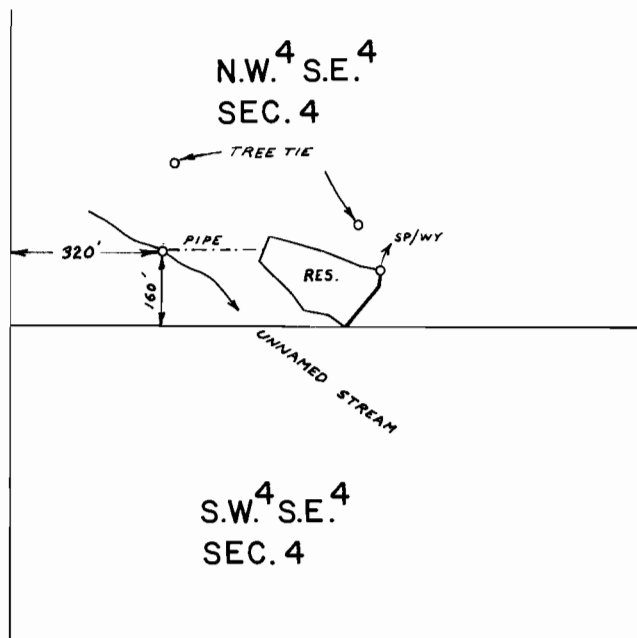

SCALE: 1" = 400 FT.

FINAL PROOF SURVEY
UNDER

Application No. R-48490 Permit No. R-5888
IN NAME OF

EDWARD L. YARBROUGH

Surveyed APR. 19 1979, by B. SUND

P.T.S. - 1979-14-A
TIE: BAX-4AA-183