


T. 33 S., R. 5 W., W.M. SECTION 2

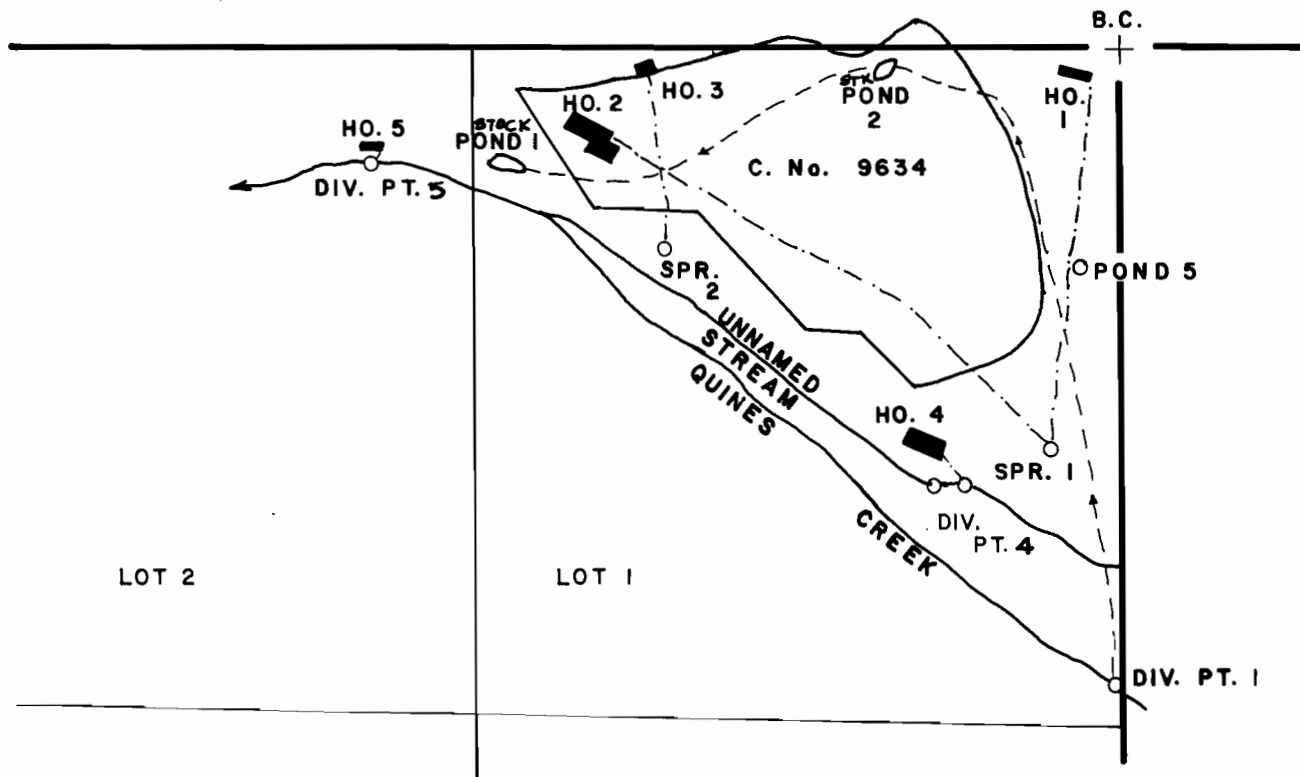

SPRING 1; 840' S. & 150' W., SPRING 2; 420' S. & 940' W., DIV. PT. 1; 1330' S. & 10' W.,
DIV. PT. 4; 910' S. & 330' W.,

ALL FROM NE CORNER SEC. 2.

SCALE: 1" = 400'

FINAL PROOF SURVEY UNDER

R-48543 R-6544
Application No. 48544 Permit No. 41089
IN NAME OF

LIVING SPRINGS, INC.

Surveyed JUNE 10, 1987, by J. M. SCHMORDE