


43222  
R-7597  
65099  
65100

T. 36 S., R. 6 E., W.M.

Fourmile Ck. & Misc.

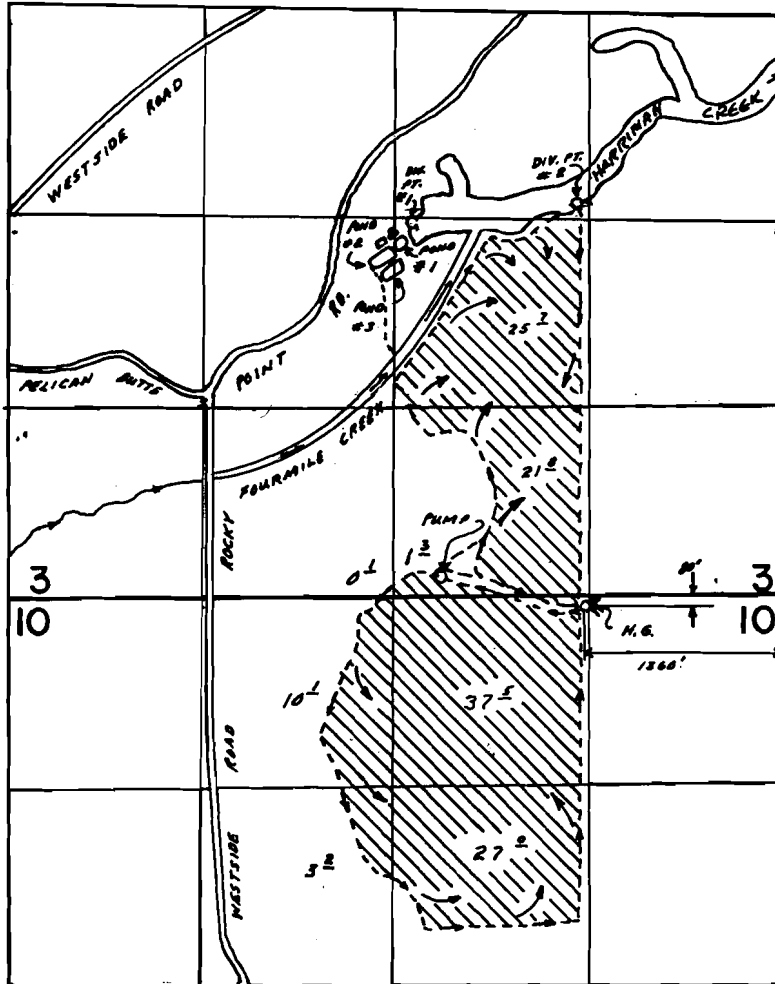

DIV. PT. 1 - 100' S & 2740' E BOTH FROM E 1/4 COR SEC 3  
DIV. PT. 2 - 80' N & 3900' E

SCALE: 1" = 1320'

### FINAL PROOF SURVEY UNDER

R-57463                      R-7597  
Application No. 48758    Permit No. 43222.....  
IN NAME OF

**ELDON V. & PEGGY M. STIVERS**

Surveyed AUG. 19... 19.87., by M. SCHMORDE...