

# T. 36 S., R. 2 W., W.M.

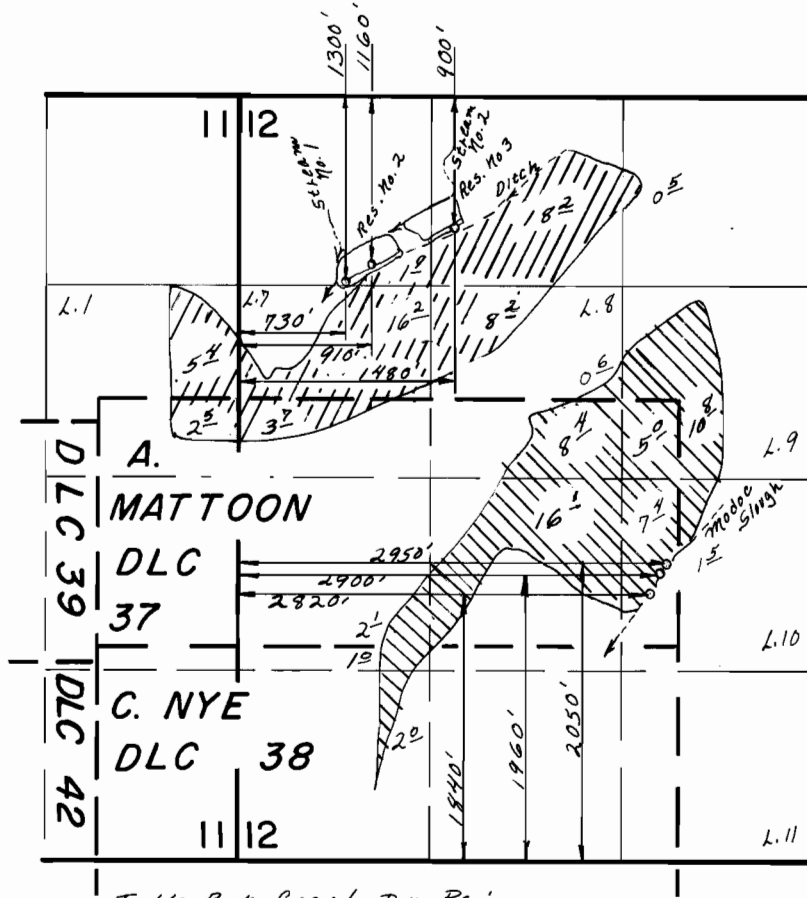


Table Rock Canal Div. P.C.:  
 420' S, 1810' E. from NW cor. Sec. 6,  
 within NE 1/4 NW 1/4 Sec. 6, T. 36 S., R. 1 W. W.M.

## FINAL PROOF SURVEY

UNDER

R-49915  
49916

R-6160  
38079

Application No. 49917 Permit No. 38080

IN NAME OF

.....MODOC ORCHARD CO.....

Surveyed MAY 29, 1986, by B. S. JAMES.

