


T. 25 S., R. 4 W., W. M.

SECTION 7

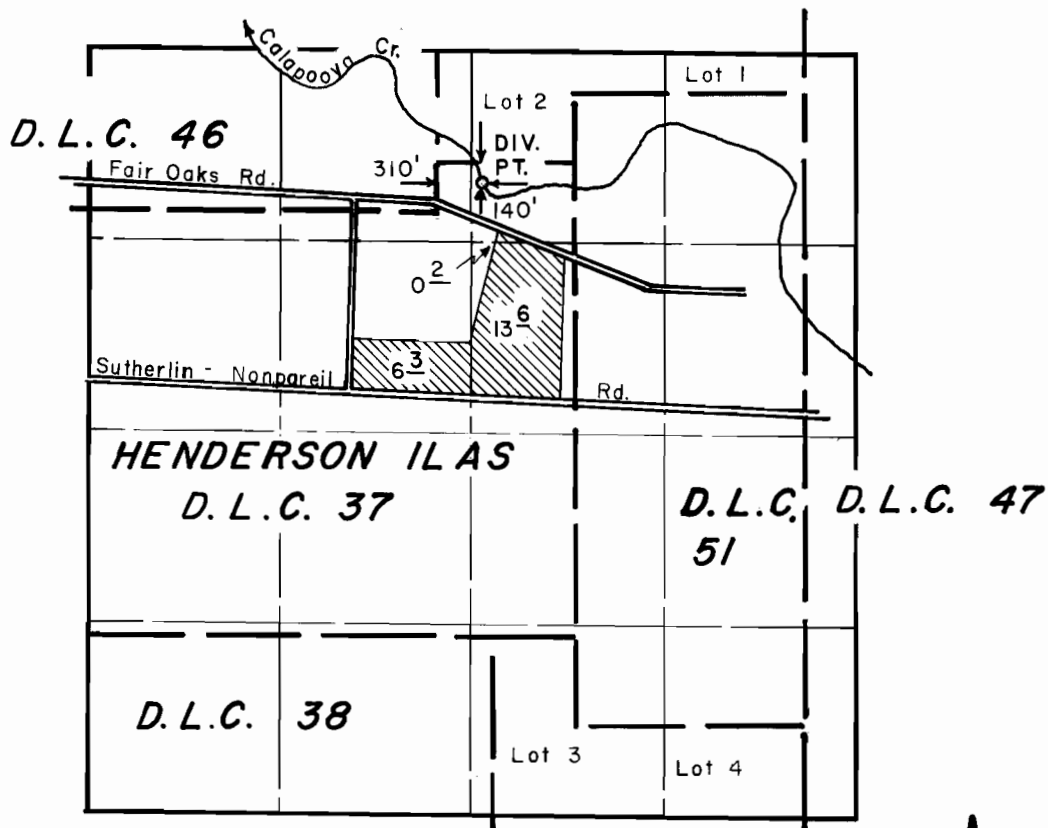

SCALE: 4" = 1 MILE

FINAL PROOF SURVEY UNDER

Application No. 50527 Permit No. 38153
IN NAME OF

Jack Morrise

Surveyed JUNE 9 1987, by J. M. SCHMORDE