


T.32S.,R.45E.,W.M.

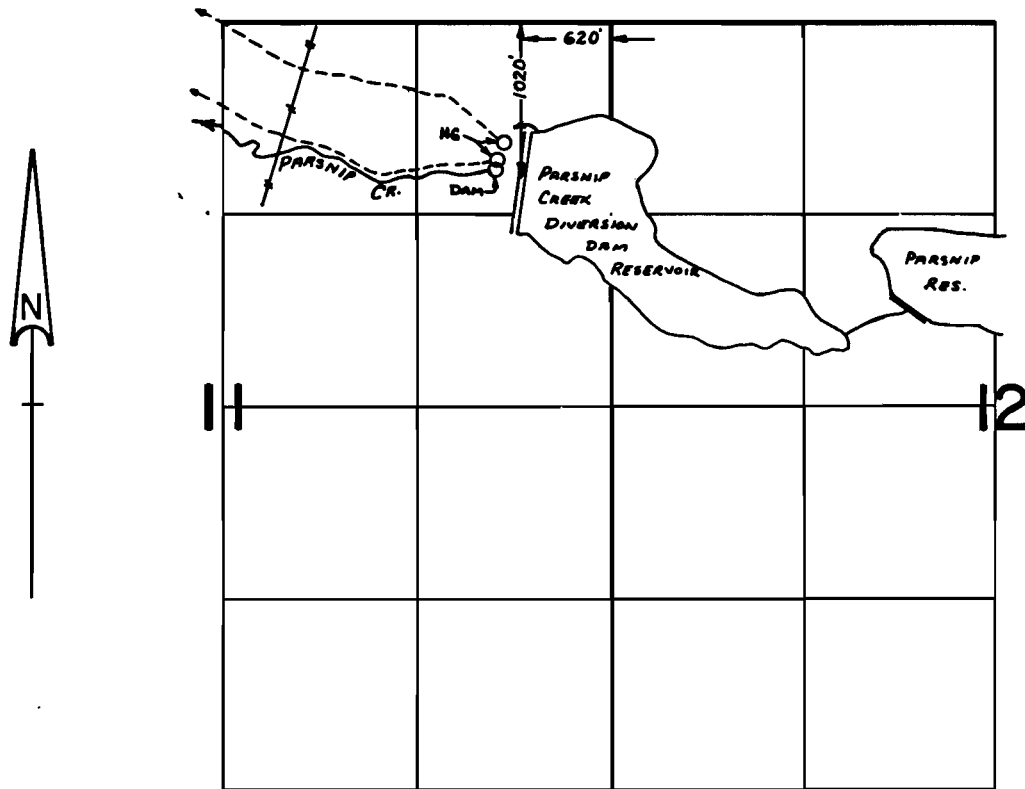

SCALE: 1" = 1320'

FINAL PROOF SURVEY
UNDER

Application No. R-50706 Permit No. R-6446
IN NAME OF

JACA BROTHERS, INC.

Surveyed Oct. 16, 1985, by L. M. TOLL