


T. 26S., R. 14W., W.M.

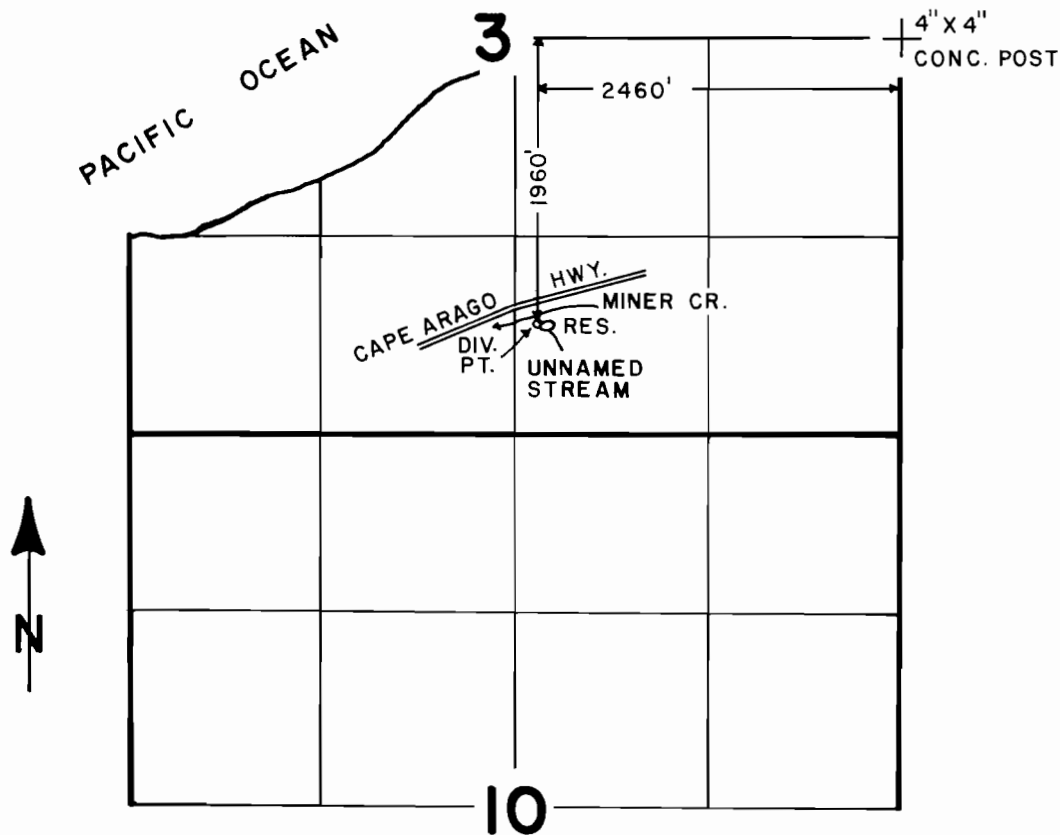

SCALE: 4" = 1 MILE

FINAL PROOF SURVEY UNDER

R-51265 R-6230
 Application No. 51266 Permit No. 38819

IN NAME OF

HERMAN J. VERMEER

Surveyed JULY 29 1986, by J.M. SCHMORDE