


T. 40S., R. 8W., W.M.

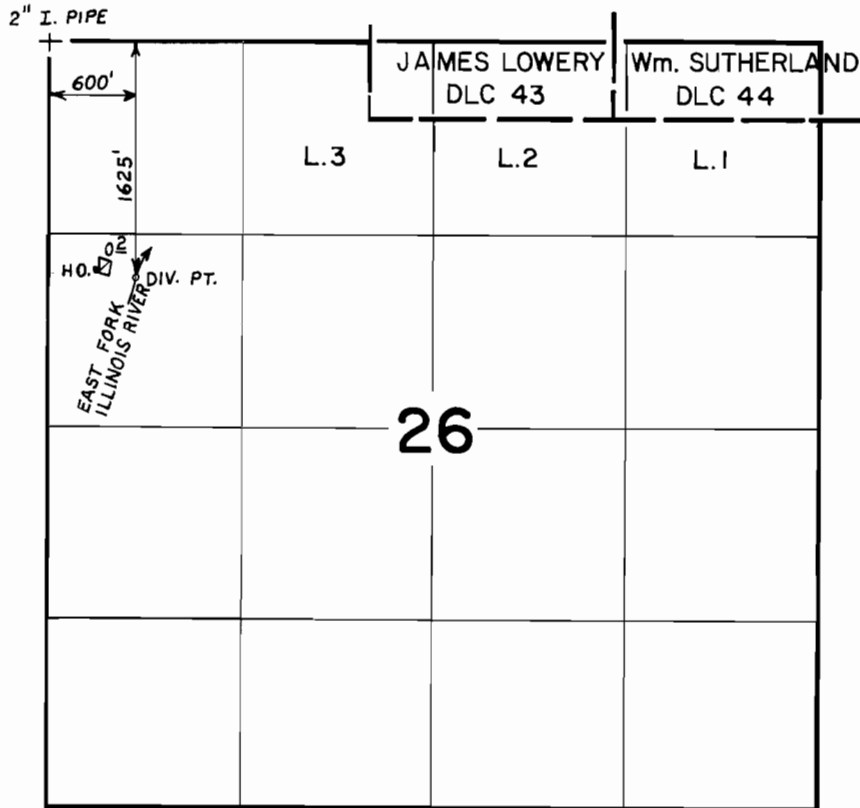

SCALE: 4" = 1 MILE

FINAL PROOF SURVEY UNDER

Application No. 51753 Permit No. 39132.....
IN NAME OF

ANN M. KELLUM.....

Surveyed AUG. 26 1982, by BRUCE R. SUND