
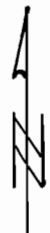


# T.5S., R.39E., W.M.

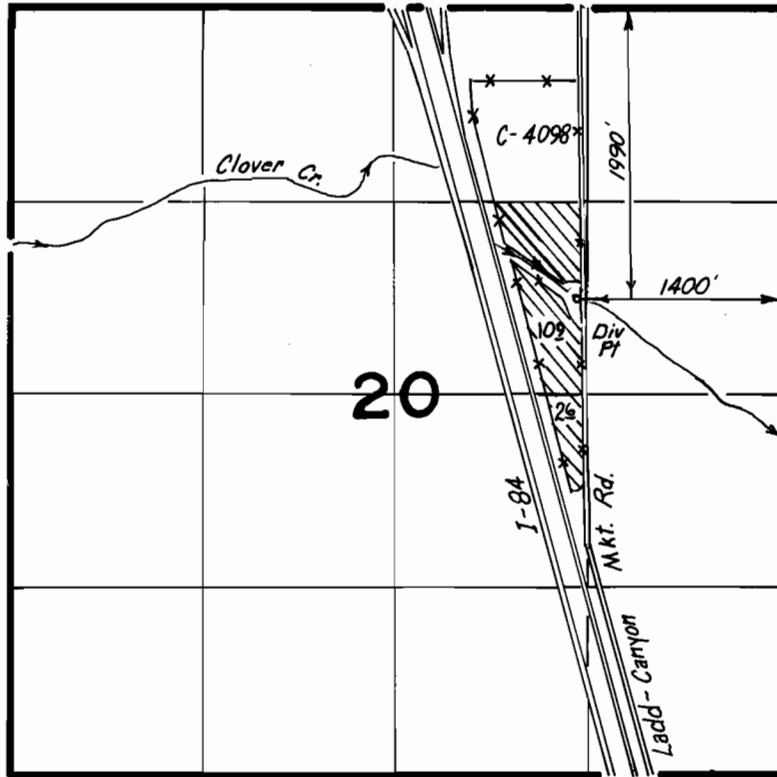

Scale: 1" = 1320'

## FINAL PROOF SURVEY UNDER

Application No. 54138 Permit No. 40529  
IN NAME OF

LEAL W. & BONNIE D. GRAHAM

Surveyed 4-1 1988, by Vern Church