
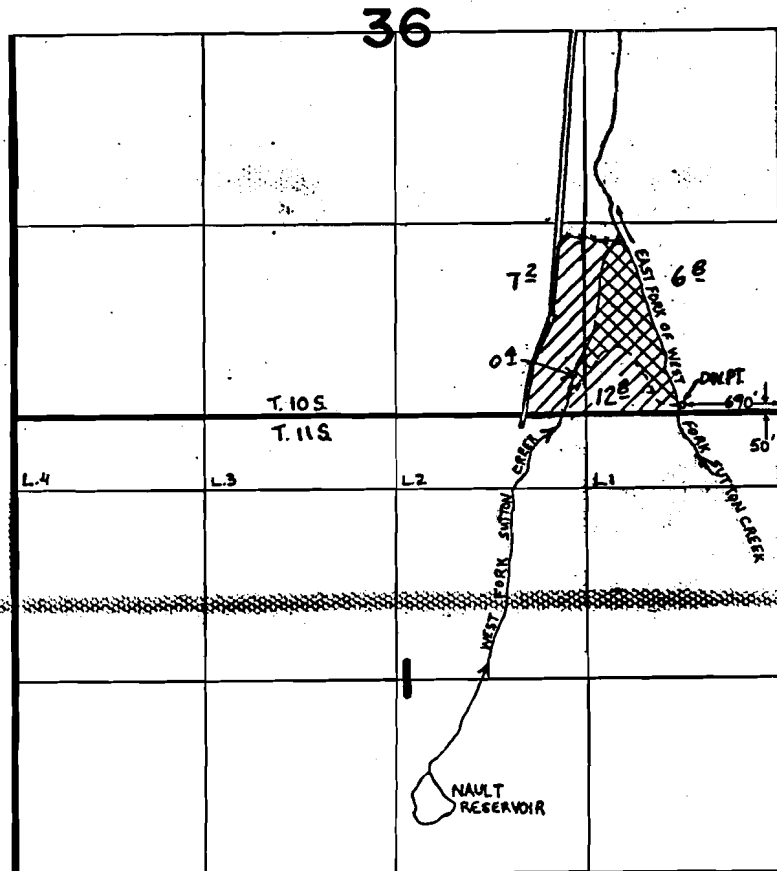


T.10 & 11 S. R.40 E. W.M.

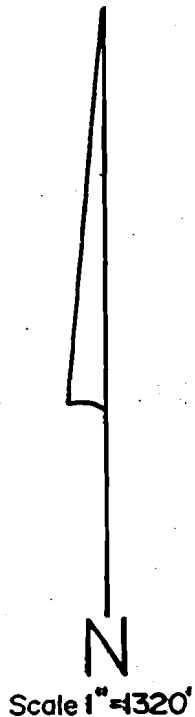

PERMIT 40731

T-3420

FINAL PROOF SURVEY UNDER TRANSFER 3420

Application No. 54331... Permit No. 40731.....
IN NAME OF

.....FREEMAN ANGUS RANCH.....

Surveyed June 3, 1986, by V. Church.....