


T.39S, R.5W, W. M.

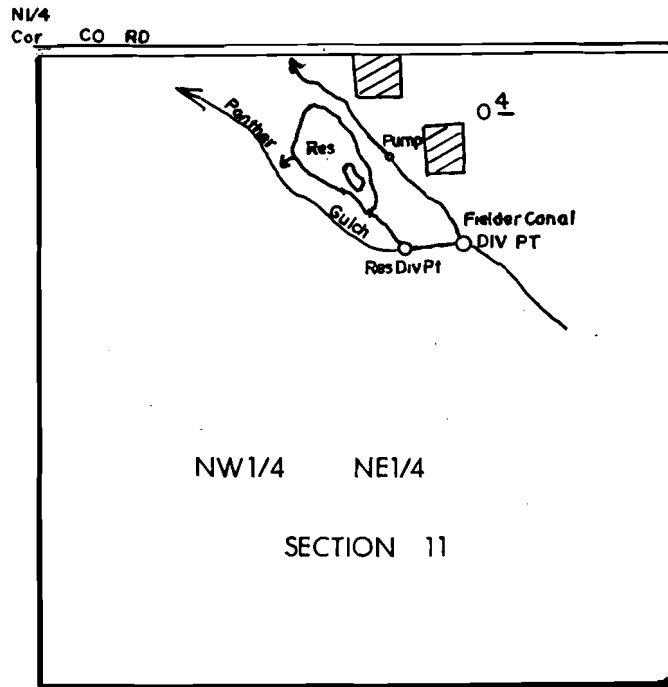

Div Pt Located 400' S & 880' E From The NI/4 Corner Of Section 11
Res Div Pt Loc 420' S & 720' E From The NI/4 Corner Of Section 11

SCALE: 1" = 400'

FINAL PROOF SURVEY UNDER

R-54531 R-6517
Application No. 54532 Permit No. 40838....
IN NAME OF

.....ROBERT A. DURSON.....

Surveyed JULY 17, 1990, by B.S. JAMES.....