


T.39S, R.5W, W. M.

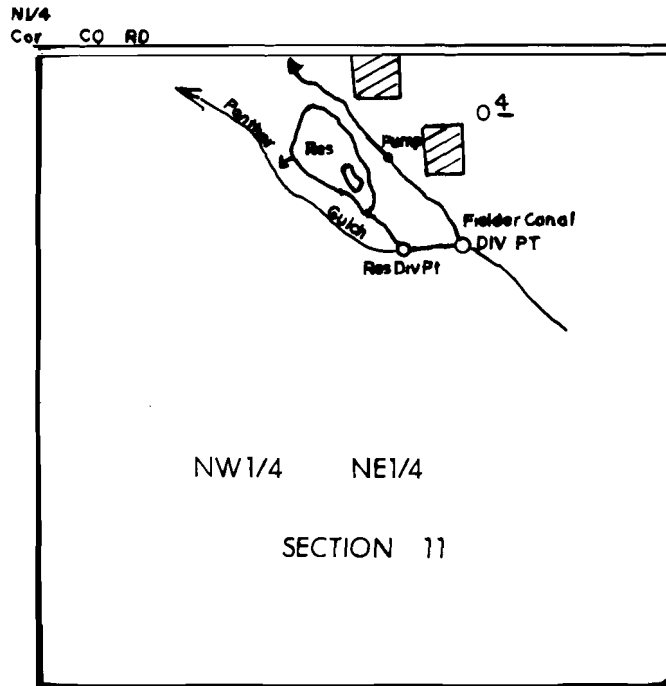

Div Pt Located 400' S 88° E From The N1/4 Corner Of Section 11  
Res Div Pt Loc 420' S & 720' E From The N1/4 Corner Of Section 11

SCALE: 1" = 400'

## FINAL PROOF SURVEY UNDER

R-54531 R-6517  
Application No. 54532 Permit No. 40838....  
IN NAME OF

.....ROBERT A. DURSON.....

Surveyed JULY 17, 1990, by B.S. JAMES.....