


T.6S., R.39E., W.M.

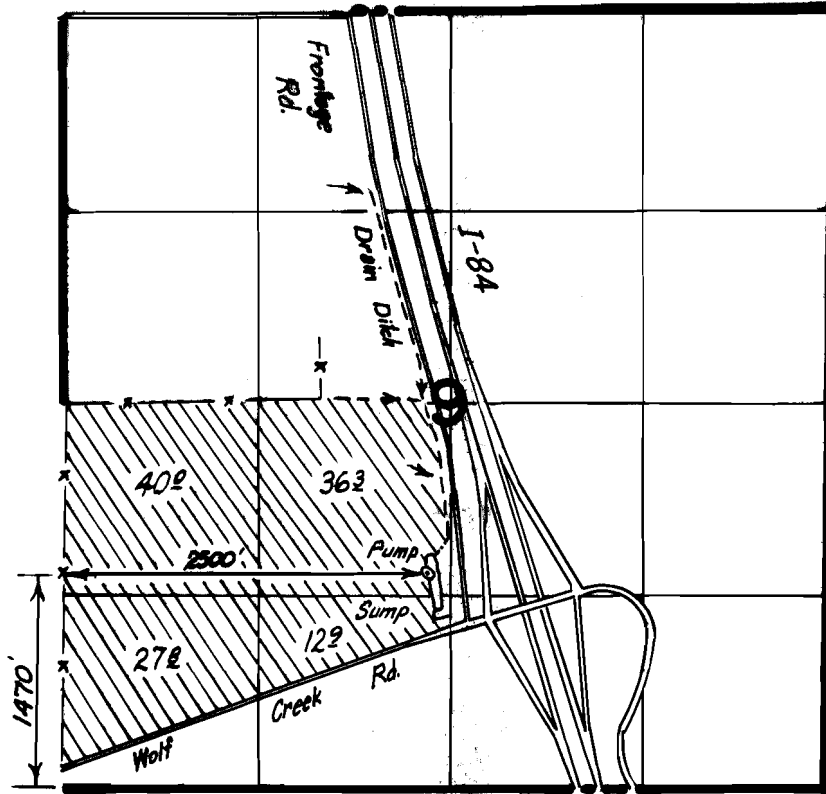

**FINAL PROOF SURVEY**  
UNDER

Scale: 1" = 1320'

Application No. **56069** Permit No. **42937**  
IN NAME OF

**GERALD H. & JUNE H. GRAY**

Surveyed **4-13** 19**87**, by **Vern Church**