




T. 29 S., R. 3 W., W.M.

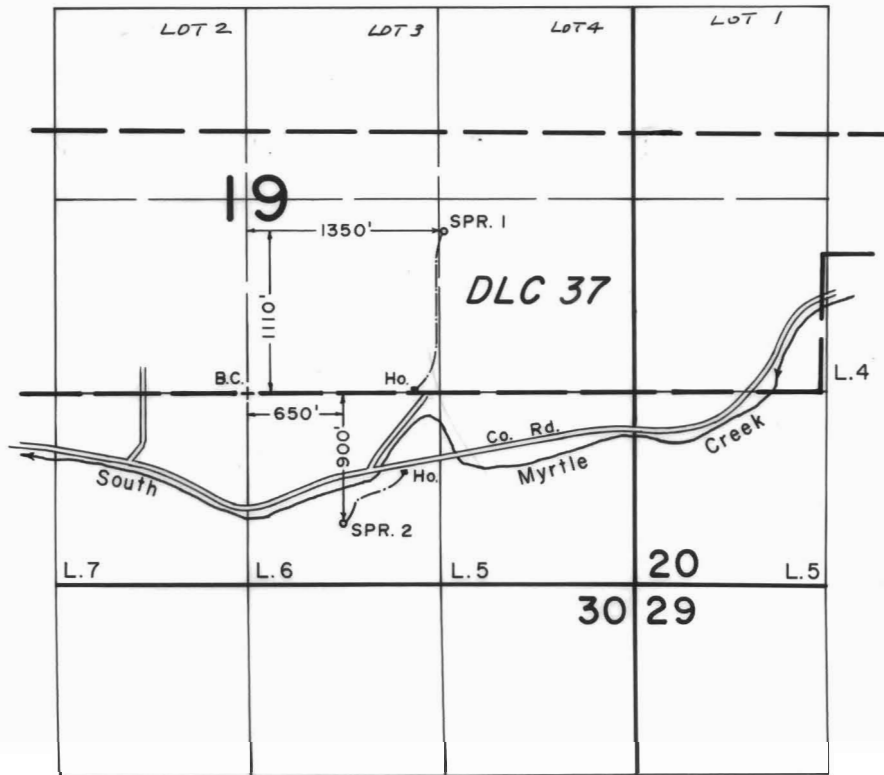

SCALE: 1" = 1320'

FINAL PROOF SURVEY
UNDER

Application No. 61050... Permit No. 45488....

IN NAME OF

FREDERICK C. WHITE

Surveyed MARCH 22 1990, by B. S. JAMES