


T. 17 S., R. 1 E., W.M.

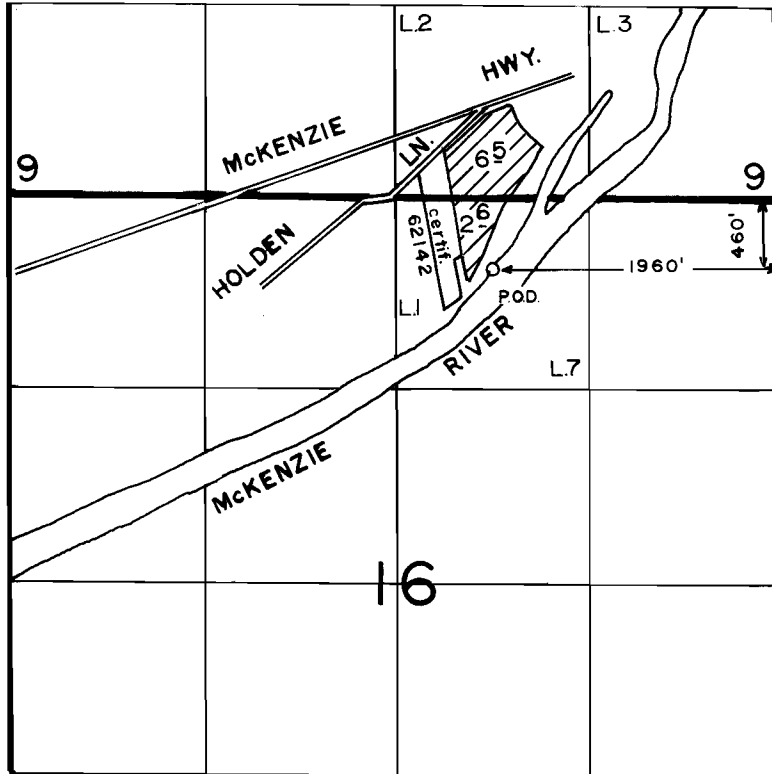

1" = 1320'

FINAL PROOF SURVEY
UNDER

Application No. 68728 Permit No. 49704
IN NAME OF

EDWARD P. BARTON + Curt + Hellen Cogswell

Surveyed JULY 26 1990, by T.M. WARREN

8-24-90 DSM
DBQ-3H-177