


T26S. R6W.WM

SCALE 1" = 1320'

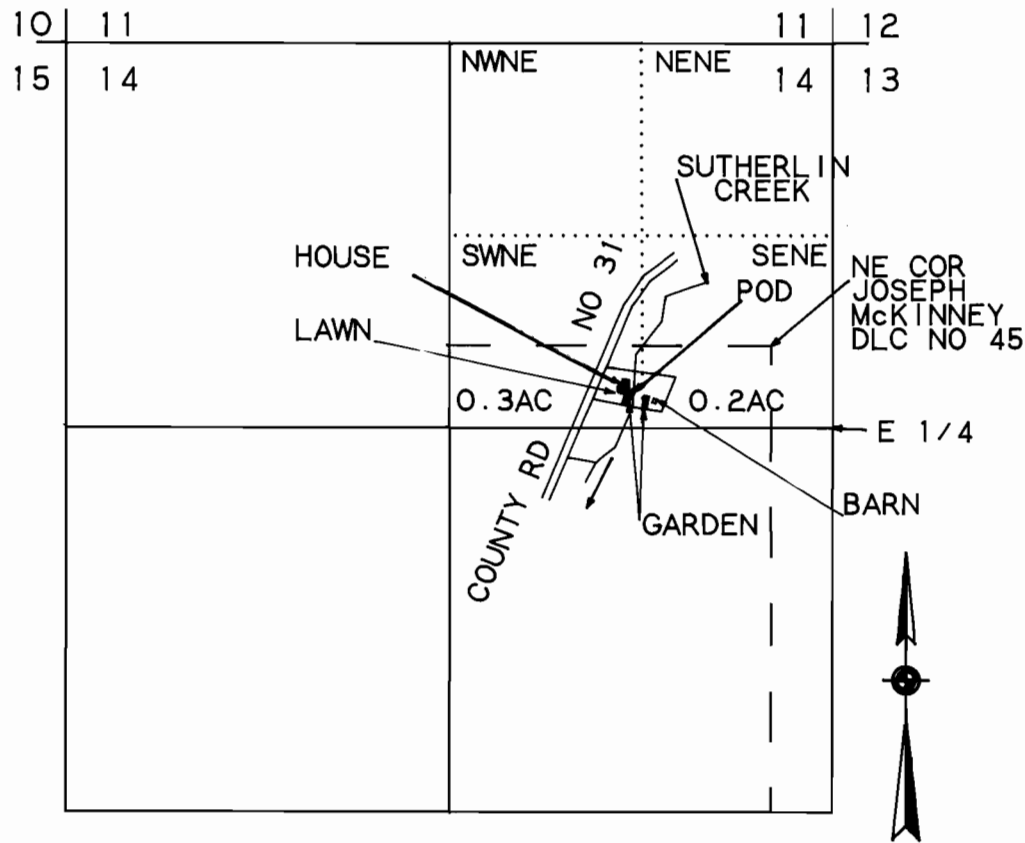

POD 1360 FT W AND 230 FT N FROM E 1/4 COR SEC 14

FINAL PROOF SURVEY  
UNDER

Application No. 69888 Permit No. 50742

IN NAME OF

ROGER D OR DOROTHY A HUTCHINGS

Surveyed August 20, 1990 by M E Farr

