


T.40S., R.14W., W.M.

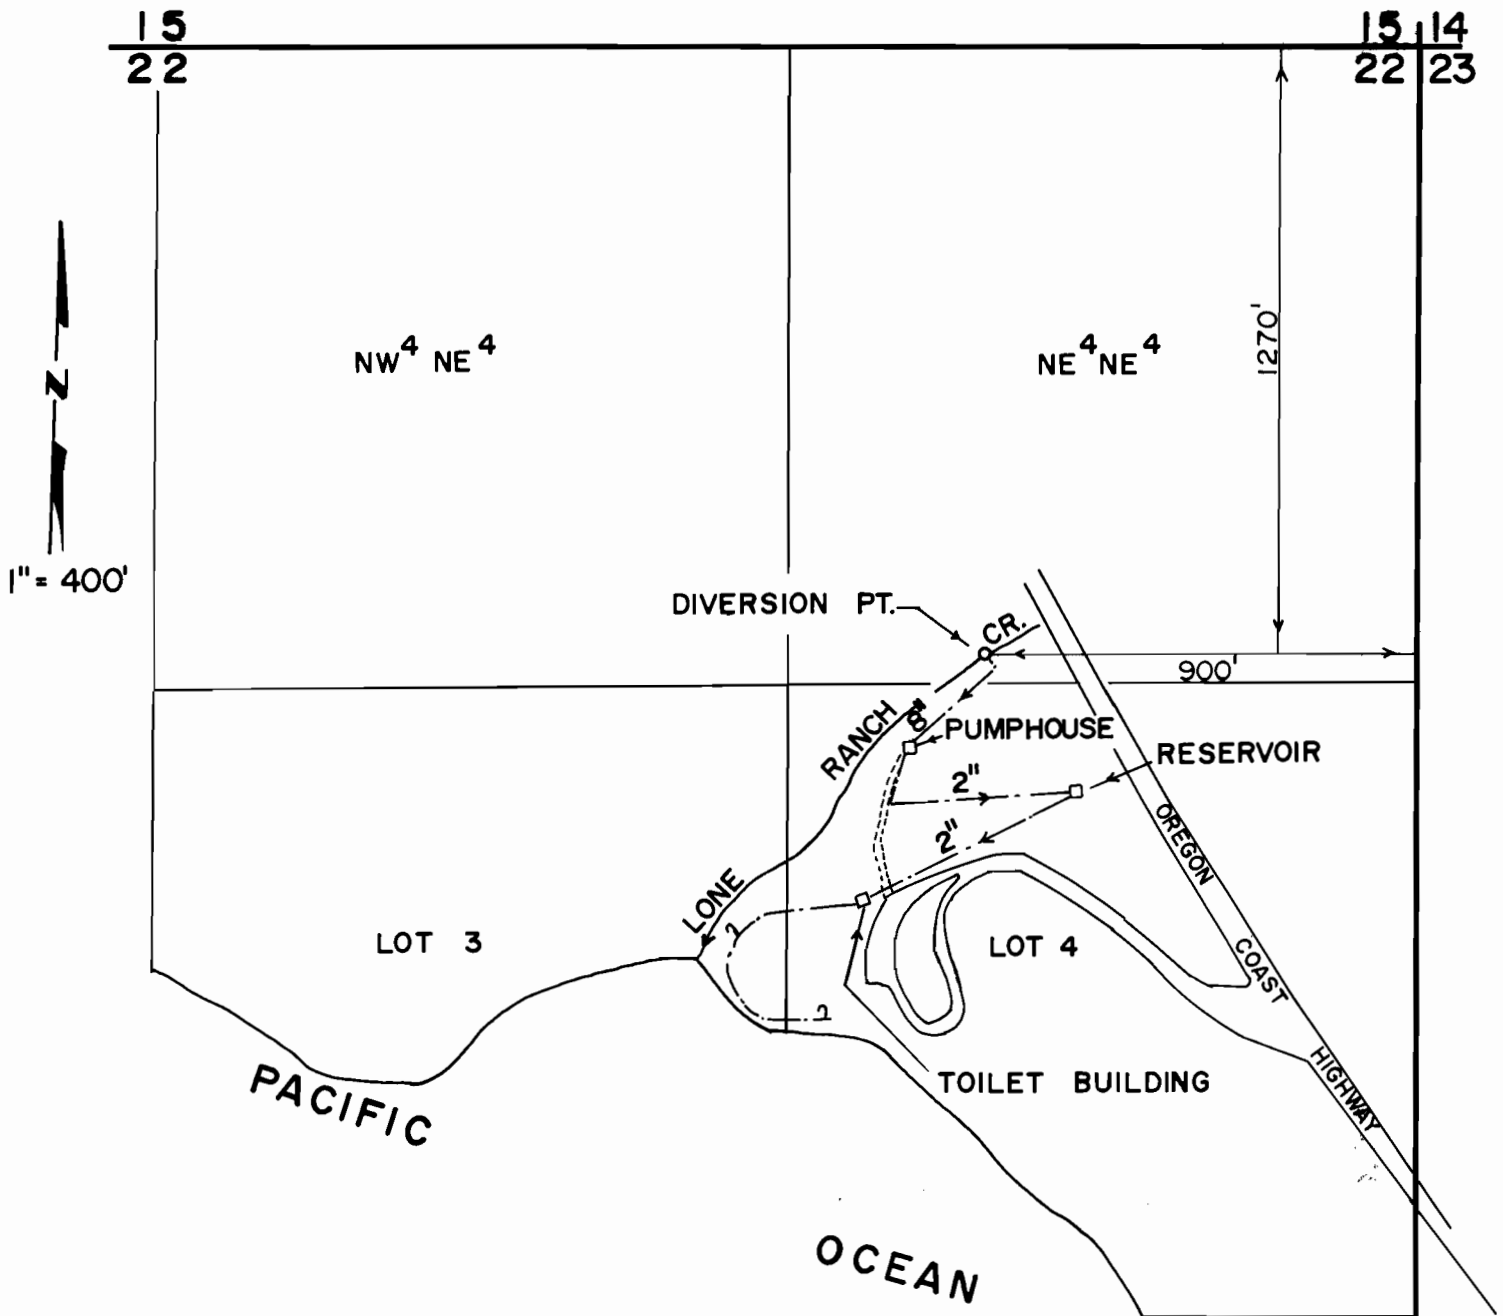

FINAL PROOF SURVEY
UNDER

Application No. 69941 Permit No. 50707

IN NAME OF

OREGON STATE PARKS DEPT.

Surveyed 7-26, 1990

by Andrew T. Blachly

THE PURPOSE OF THIS MAP IS TO IDENTIFY THE LOCATION OF THE WATER RIGHT. IT IS NOT INTENDED TO PROVIDE INFORMATION RELATIVE TO THE LOCATION OF PROPERTY OWNERSHIP BOUNDARY LINES.

