


T. 15 S., R. 12 W., W.M.

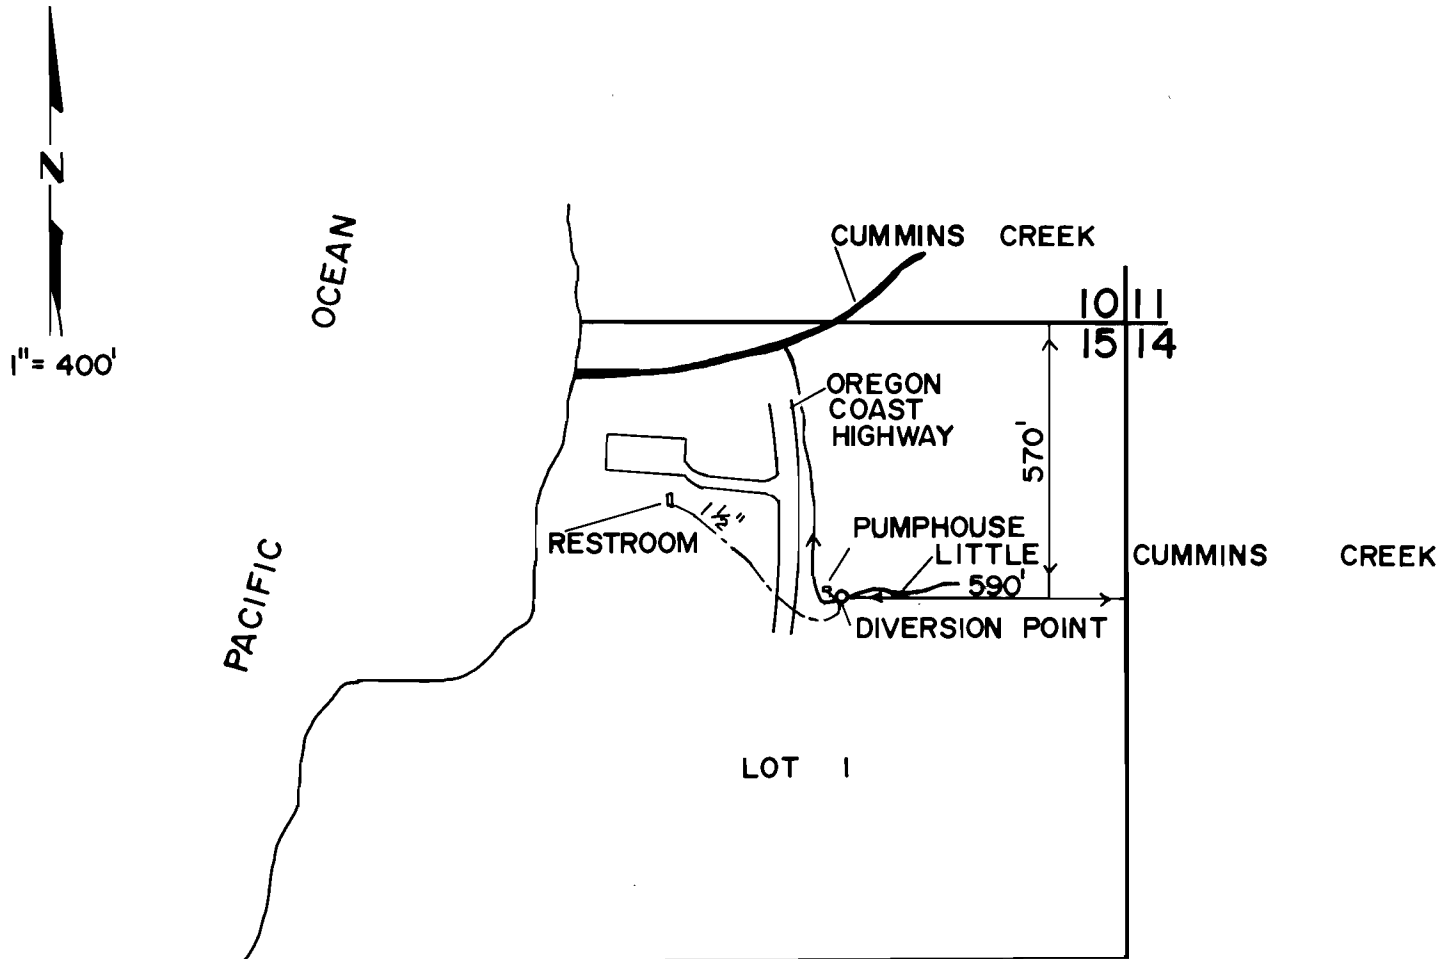

THE PURPOSE OF THIS MAP IS TO IDENTIFY THE LOCATION OF THE WATER RIGHT. IT IS NOT INTENDED TO PROVIDE INFORMATION RELATIVE TO THE LOCATION OF PROPERTY OWNERSHIP BOUNDARY LINES.

FINAL PROOF SURVEY
UNDER

Application No. 69993 Permit No. 50745

IN NAME OF

OREGON STATE PARKS DEPARTMENT

Surveyed 7-26-90

by Andrew T. Blachly

