


**FINAL PROOF SURVEY
MIVALBERTA PARK**


Township 31 South Range 4 West WM Section 27

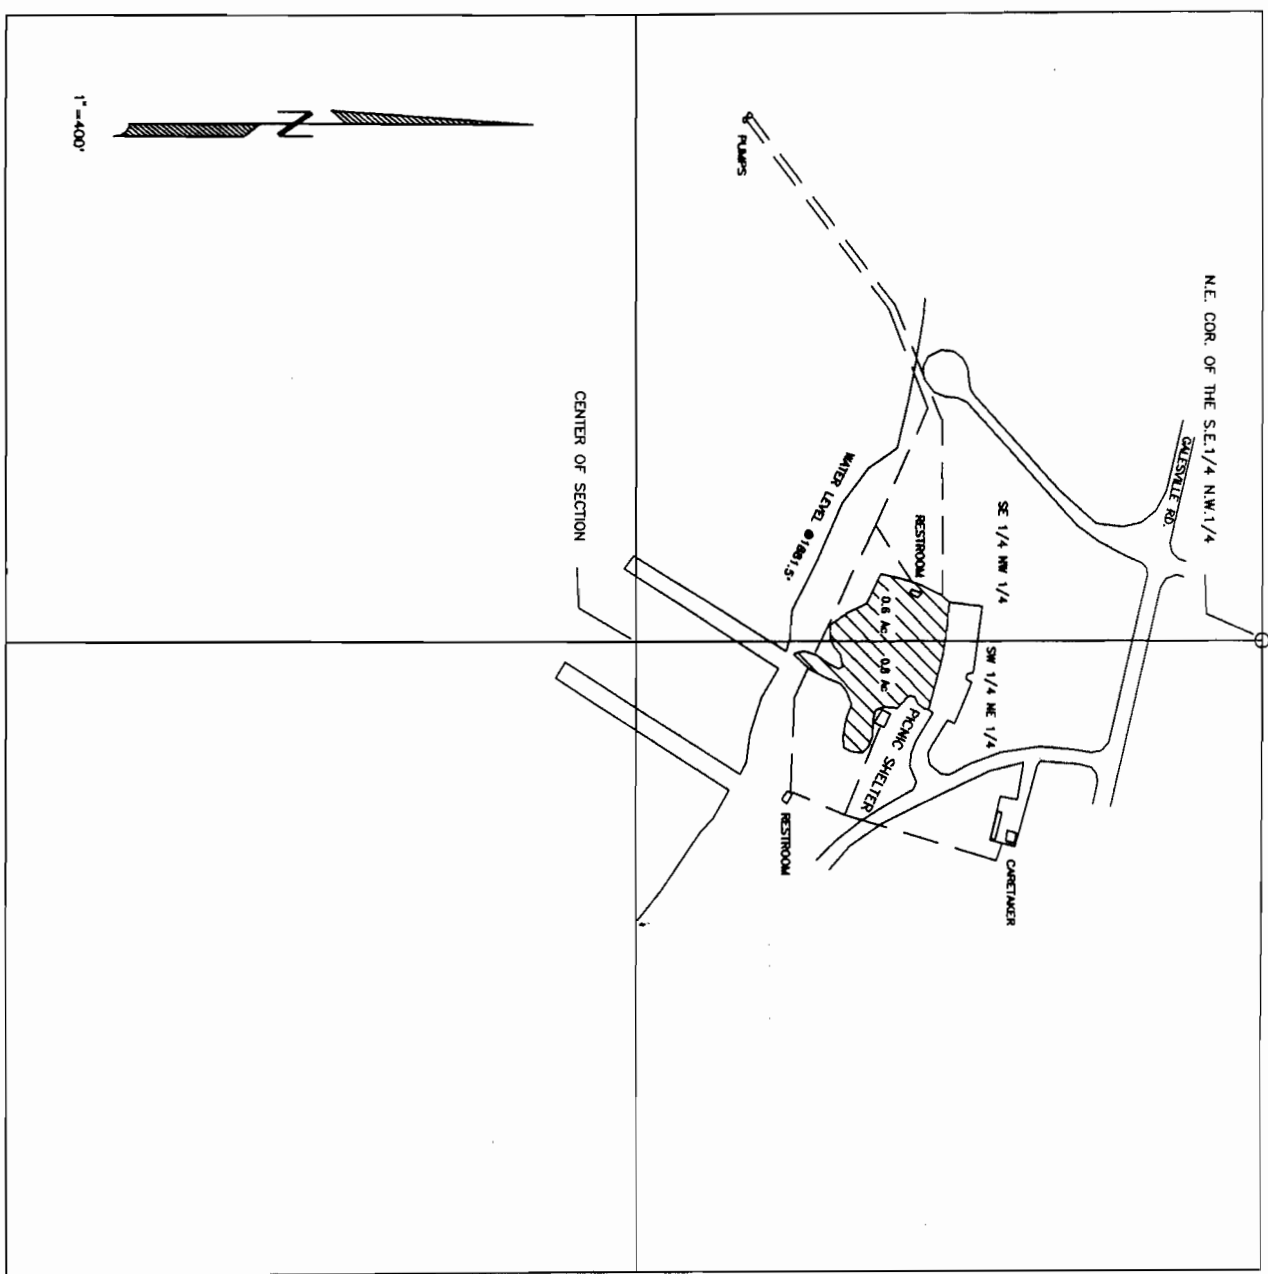

The Point of Diversion from the Galesville Lake is 1050 feet South and 1100 feet West from the NE Corner of the SE $\frac{1}{4}$ NW $\frac{1}{4}$ (Brass Cap) of Section 27, being within the SE $\frac{1}{4}$ NW $\frac{1}{4}$ of Section 27, Township 31 South, Range 4 West WM, Douglas County, Oregon.

NOTE: THIS MAP IS INTENDED ONLY TO SHOW WATER RIGHT LOCATION AND IN NO WAY REFLECTS PROPERTY OWNERSHIPS OR BOUNDARIES.

Township 31 South Range 4 West W.M.

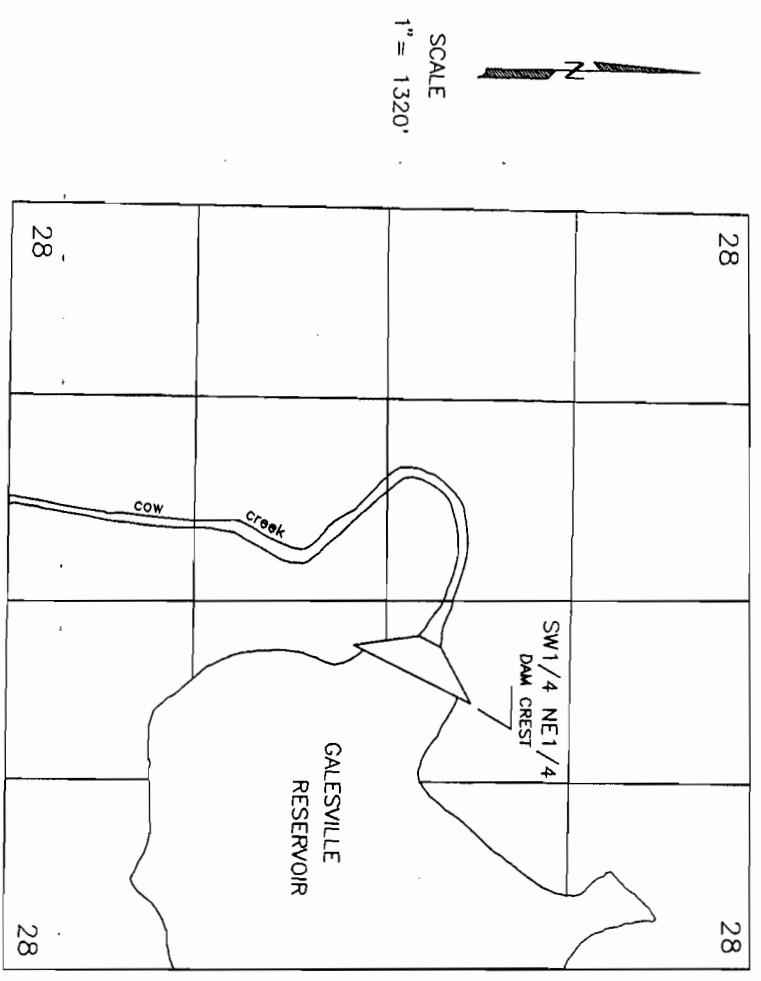

Dam (Pod)=2920'N.:2060'W. From S.E. Cor. Sec. 28

GALESVILLE PROJECT
Douglas County Oregon
Contract No. NDNE _____
Point of Diversion:
2,920'N.; 2,060'W
From SE Cor. Sec. 28
Within Township 31 South
Range 4 West W.M.

