


T.14S. R.12E. W.M.

65128
T5592

72411
T6005

75843
T8026

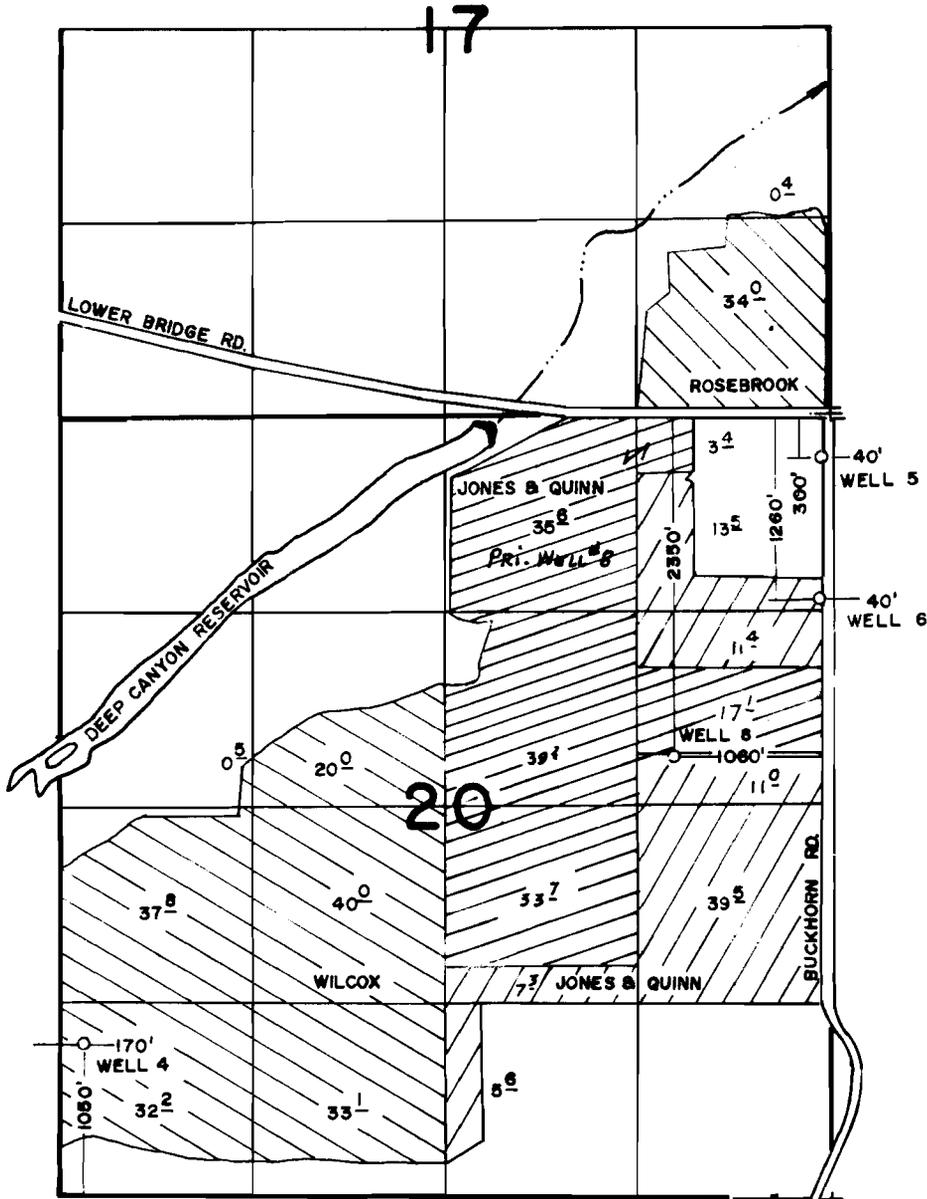

FINAL PROOF SURVEY
UNDER

Application No. G-7609 Permit No. G-7360.....
IN NAME OF

Kent, Helen, Adrian & Ollis Wilcox et al

Surveyed AUG., SEP. 1976, by R. MUCKEN.....
INSPECTED MAY 14, 1980, BY L.H. NUNN

#1 of 2

G-7360

1976-2-4 UN

