


CANCELLED
T. 2N. R. 32E. W.M.

G-8590

65131
33747

T. 2N., R. 32E., W.M.

see T-5981

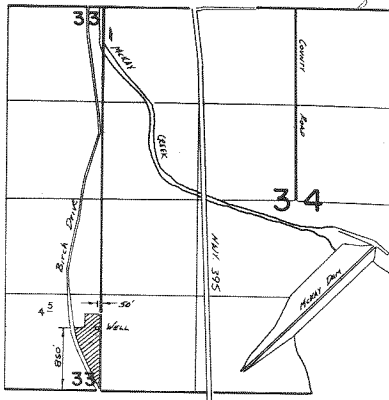

FINAL PROOF SURVEY
UNDER

Application No. G-9244 Permit No. G-8590
IN NAME OF

ROBERT D. WEEKS

Surveyed May 12 1988, by V. Church