


T.9 S. R.21 E.W.M.

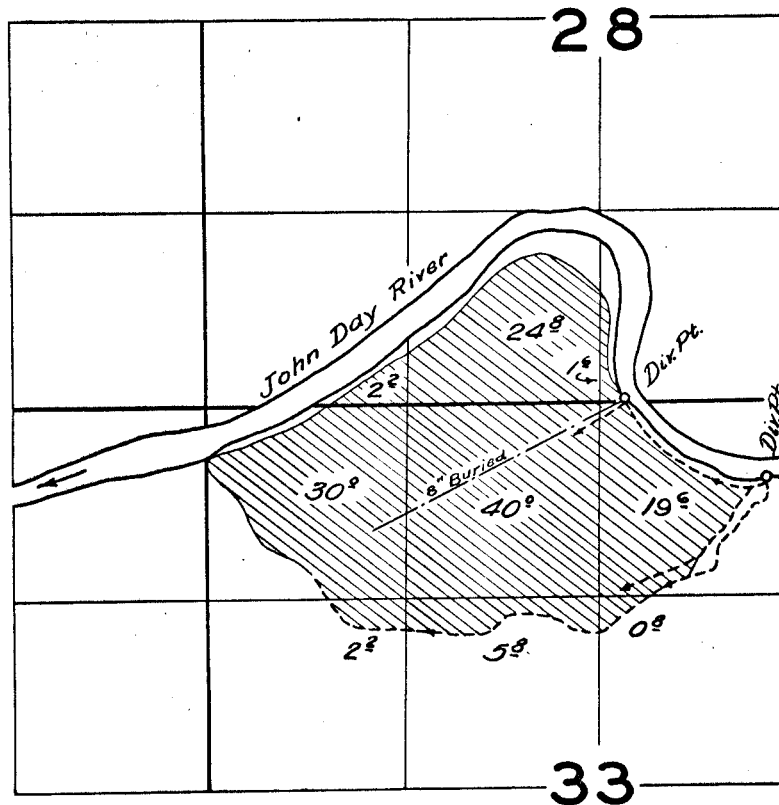

**FINAL PROOF SURVEY**  
UNDER

Application No. 27990 Permit No. 22735  
IN NAME OF

.....*Carl Fischer*.....

Surveyed *June 23* 1959, by *C. Q. Bartels*