T. 7 S., R. 1 W., W. M.

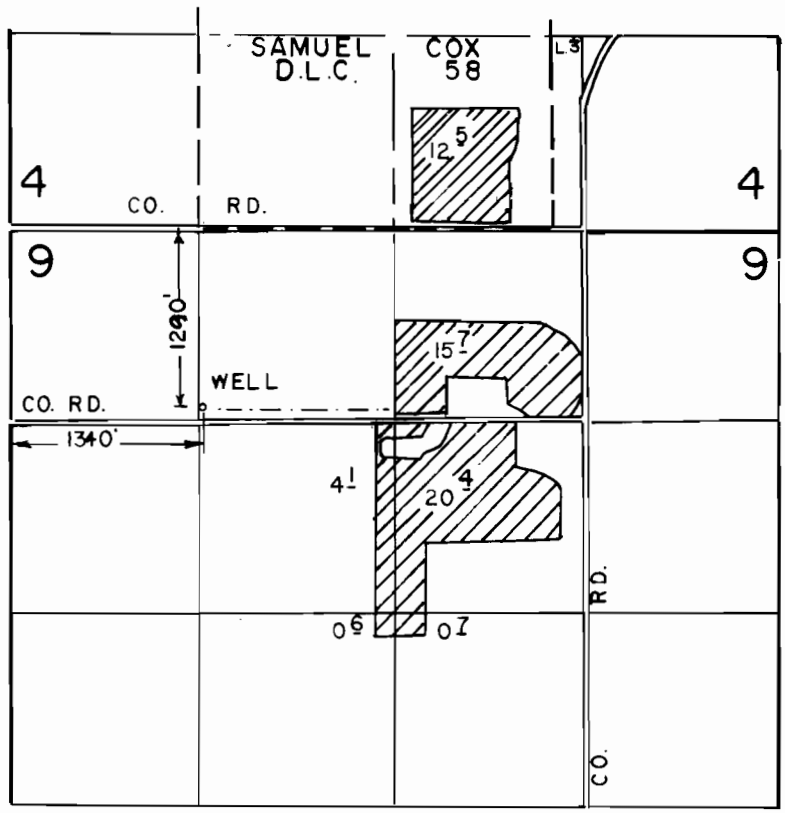

N

1" = 1320'

FINAL PROOF SURVEY
UNDER

Application No. G-11668 **Permit No.** G-10769
IN NAME OF

RAYMOND J. KUENZI

Surveyed MAY 29 **19**90, **by** T. M. WARREN

6-25-90 DSM
41047-278-132D