


T.2S.R.4E.W.M.

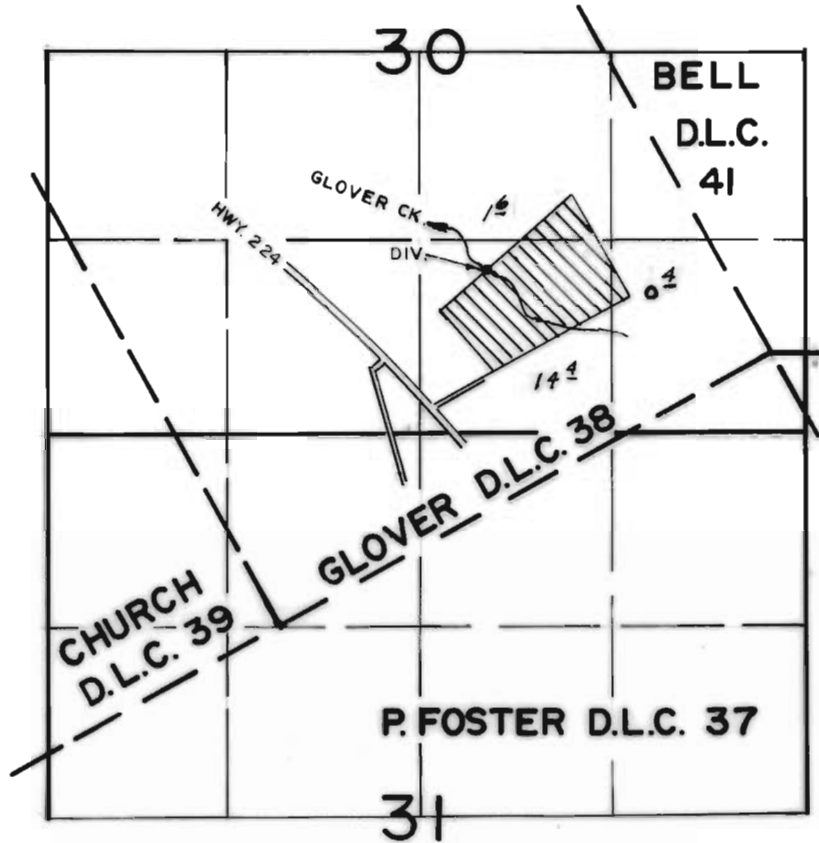

DIV. PT. LOC.: 2450' N. & 1450' E. FROM SW. COR. GLOVER D.L.C. 38

FINAL PROOF SURVEY
UNDER

Application No. 52676 Permit No. 39689.....
IN NAME OF

H. CLIFTON GLOVER

Surveyed MAR. 27... 1980, by R.G. MUCKEN.....