


T.6S. R.3W.W.M.

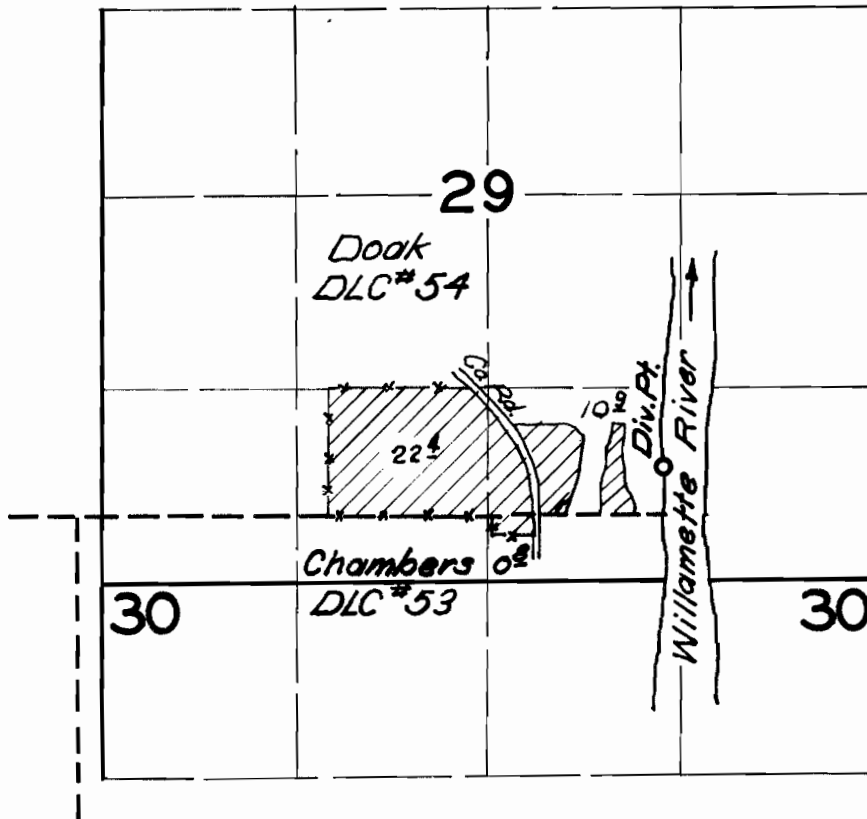

FINAL PROOF SURVEY
UNDER

Application No. 31431 Permit No. 24764
IN NAME OF

Hans Fuchs

Surveyed 29 Aug. 1962, by Carl R. Baker