


Y-5952
65152

T. 4N., R. 25E., W.M.

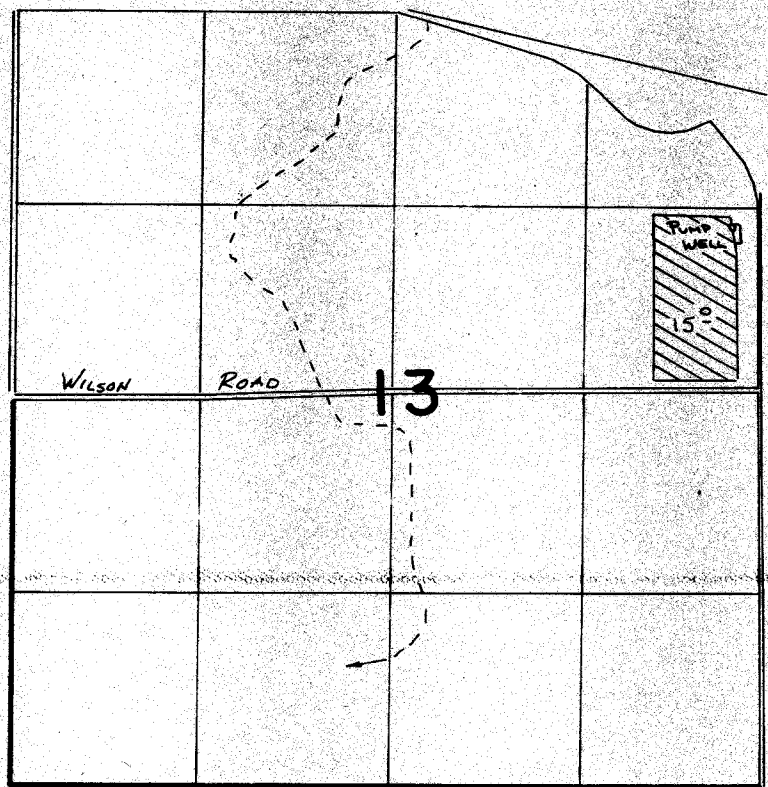

WELL LOC: 380' N. & 2460' E. FROM S 1/4 CORNER SEC. 13

SCALE: 1" = 1320'

FINAL PROOF SURVEY UNDER

Application No. **G:6351**. Permit No. **G:5952**.
IN NAME OF

HILLVIEW DAIRY, INC.

Surveyed **4-8** 19**80**, by **V. h. Church**