90684

G-5953

65153

T. 4N., R. 25E., W. M.

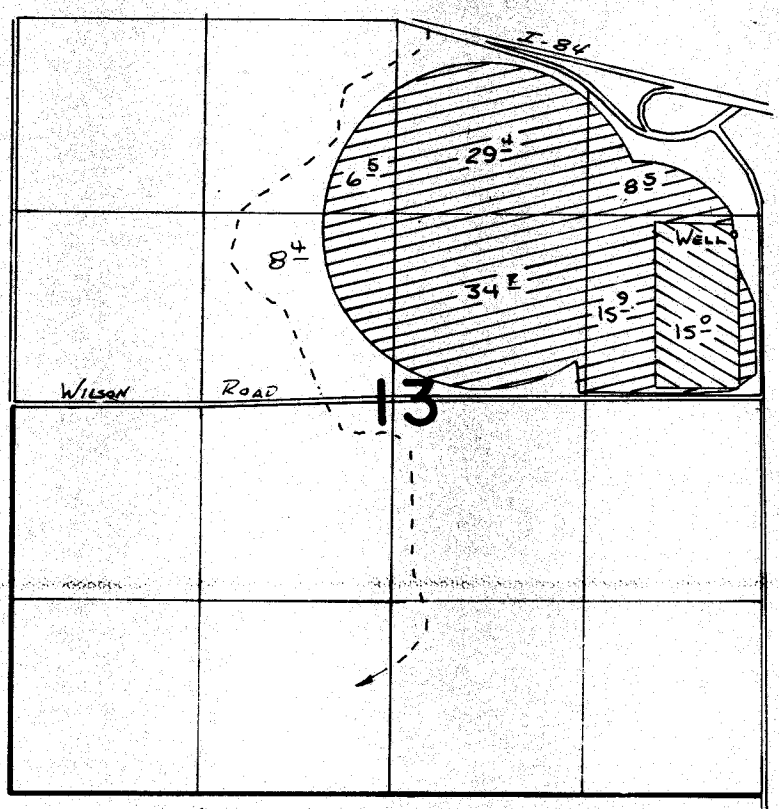

WELL LOC: 3840'N. & 2440'E. FROM S 1/4 CORNER SEC. 13

PRIMARY

SUPPLEMENTAL

SCALE 1" = 1320'

FINAL PROOF SURVEY
UNDER

Application No. G-7110 Permit No. G-5953
IN NAME OF

HILLVIEW DAIRY, INC.

Surveyed 2-2 1984., by V.L. Church

272-186
PTS-1984PA

REV. 2-27-86