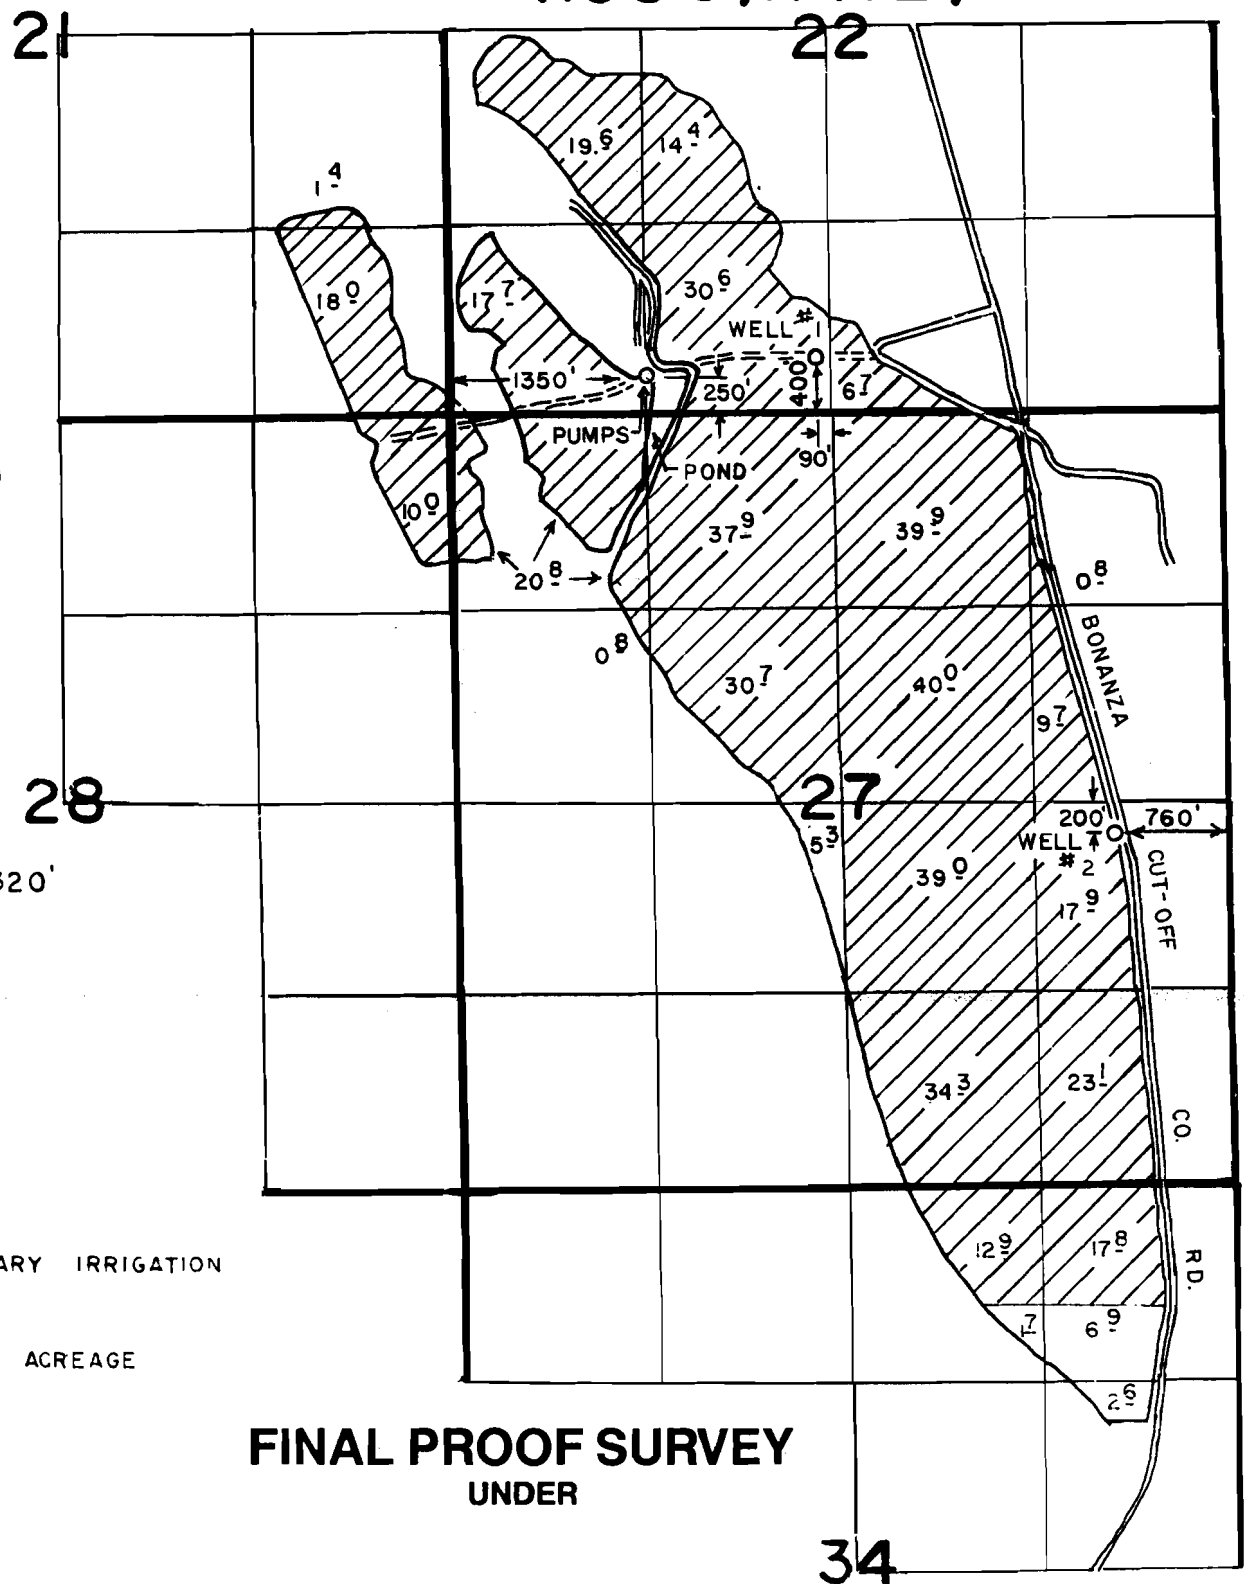

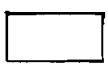


G-7465

T.38 S., R.11 E., W.M. 65155



Acct. Clerk & former Librarian

-  PRIMARY IRRIGATION
-  OVER ACREAGE

FINAL PROOF SURVEY
UNDER

Application No. G-8062 Permit No. G-7465
 IN NAME OF
ROBERT E. CHEYNE & HELEN C. CHEYNE
 Surveyed SEPT. 26 19.89, by B. W. BISHOP

4-19-90 DSM
 41035-278-69A
 41035-278-69B