


T. 2 S. R. 30 E. W.M.

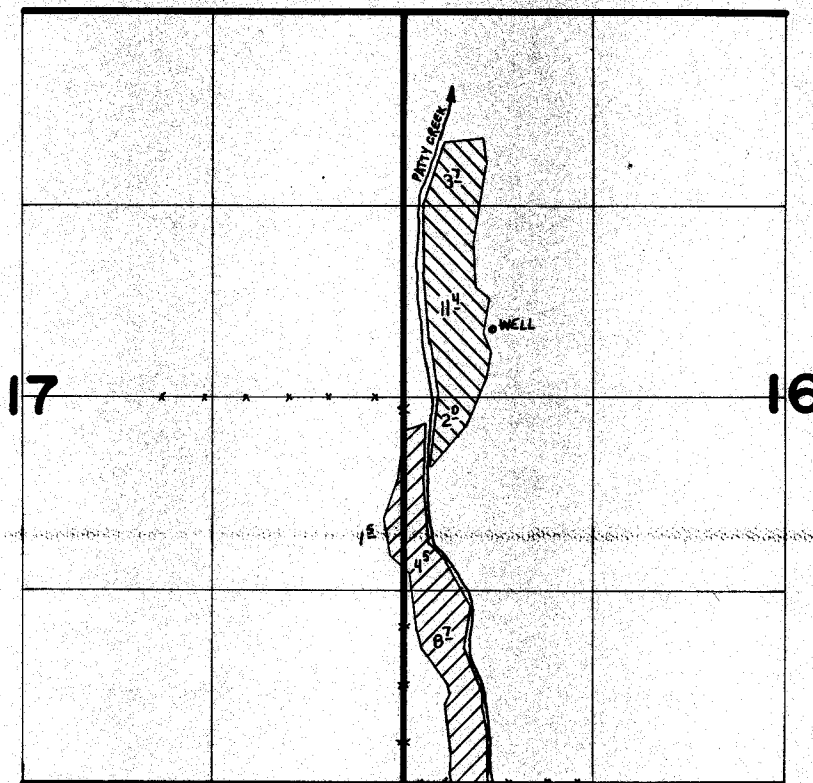

WELL LOC. 3100' N. & 620' E. FROM S.W. COR. SEC. 16



PRIMARY



SUPPLEMENTAL

FINAL PROOF SURVEY UNDER

Application No. G.8485. Permit No. G.7876.....
IN NAME OF

JOE P. DOHERTY SHEEP RANCH INC.

Surveyed March 31, 1987., by V. Church.....