


T. 1S., R. 46E., W.M

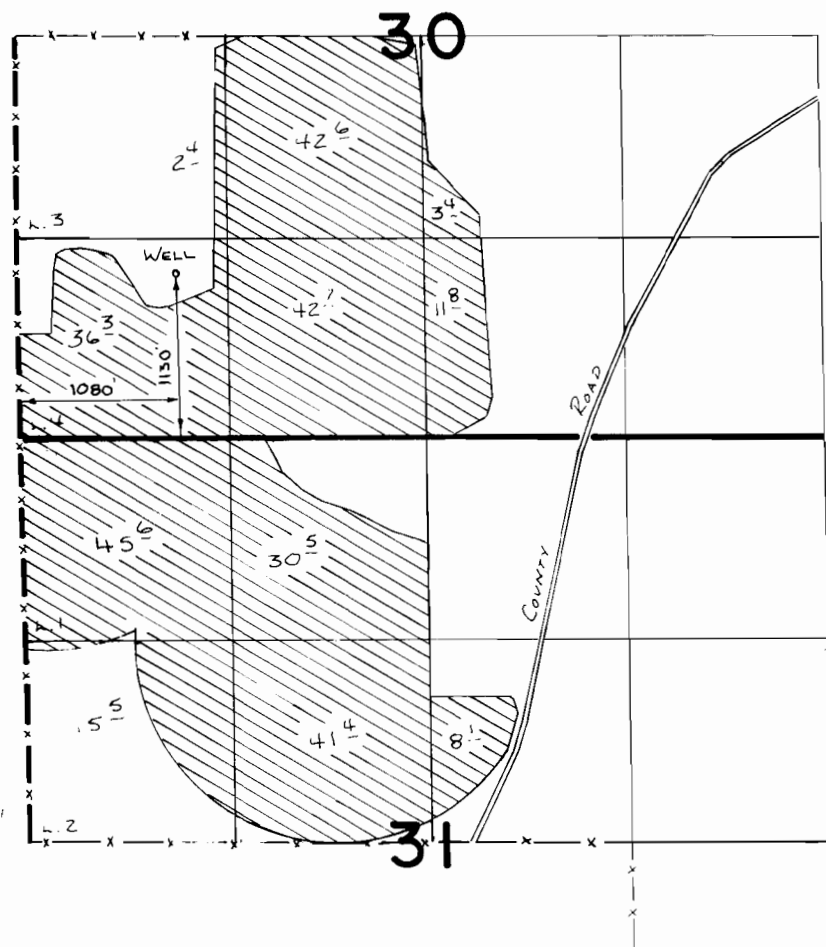

SCALE: 1" = 1320'

FINAL PROOF SURVEY
UNDER

Application No. **G:9115**... Permit No. **G:8448**
IN NAME OF

CIRCLE M. CATTLE COMPANY

Surveyed **8-26**..... 19**85**, by **V.L. Church**.....