


T. 1&2S., R. 46E., W.M.

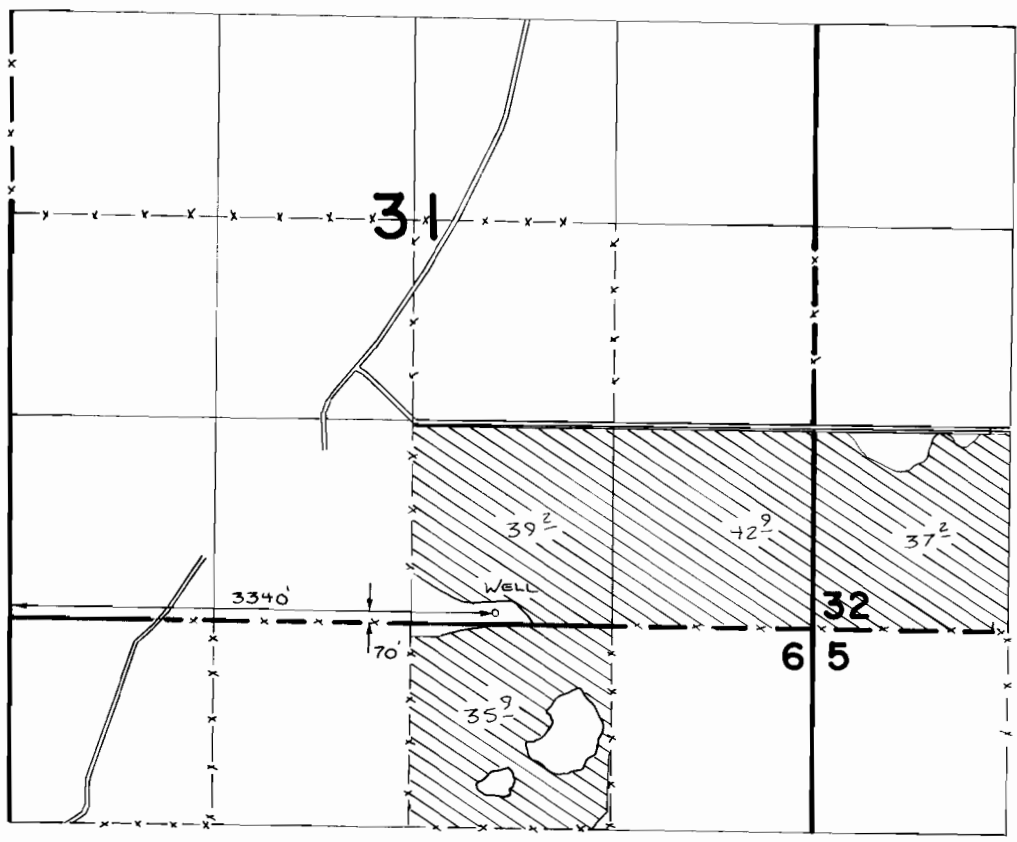

FINAL PROOF SURVEY UNDER

Application No. **G:10113** Permit No. **G:9225**
IN NAME OF

CHET ASHENBRENNER

Surveyed **8-12** 19**85**, by **V.L. Church**



SCALE: 1" = 1320'