


T. 14 & 15S., R. 4W., W.M.

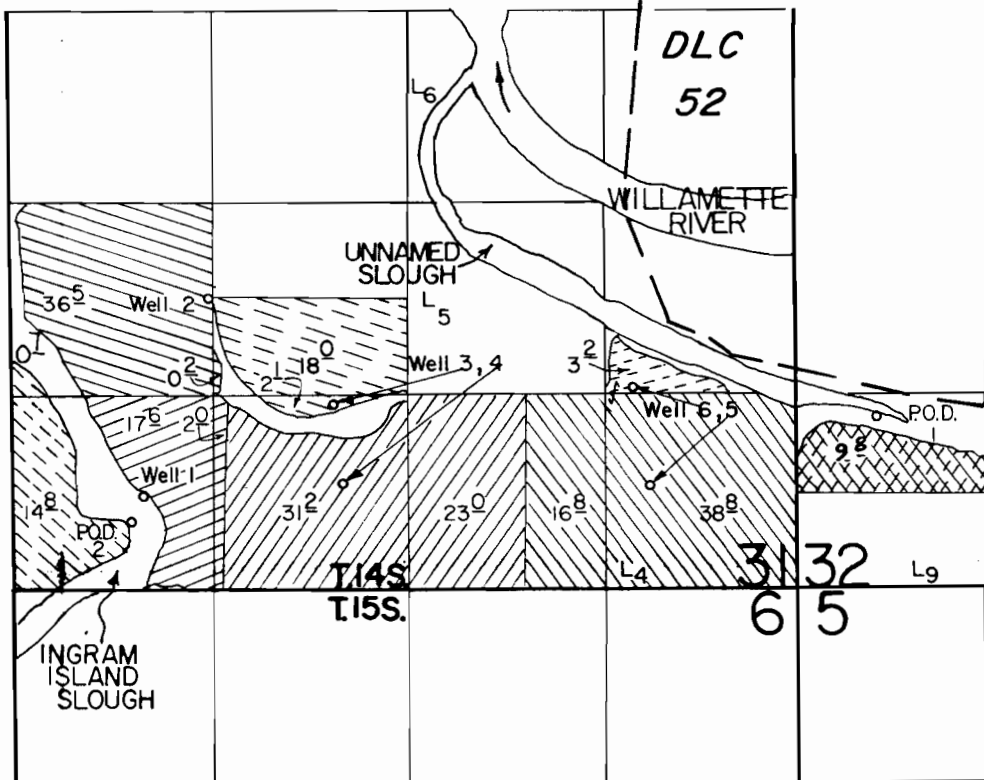

- Well 1
- Well 2
- Well 3
- Well 4
- Well 5
- Well 6
- P.O.D. 1
- P.O.D. 2

Well 1 Loc.: 640' N. & 900' E.; Well 2 Loc.: 2000' N. & 1380' E.  
 Well 3 Loc.: 1280' N. & 2230' E.; Well 4 Loc.: 730' N. & 2290' E.; all from SW Cor. Sec. 31.  
 Well 5 Loc.: 700' N. & 1000' W.; Well 6 Loc.: 1380' N. & 1120' W.; both from SE Cor. Sec. 31.  
 P.O.D. 1 Loc.: 1160' N. & 560' E. from SW Cor. Sec. 32.  
 P.O.D. 2 Loc.: 450' N. & 830' E. from SW Cor. Sec. 31.

Scale: 1" = 1320'

**FINAL PROOF SURVEY**  
 UNDER

G-11188                      G-10283

Application No. 67948... Permit No. 48113.....  
 IN NAME OF

DELBERT C. PITCHER

Surveyed Sept. 6 1988, by T. Warren