



T. 14S., R. 5W., W.M.

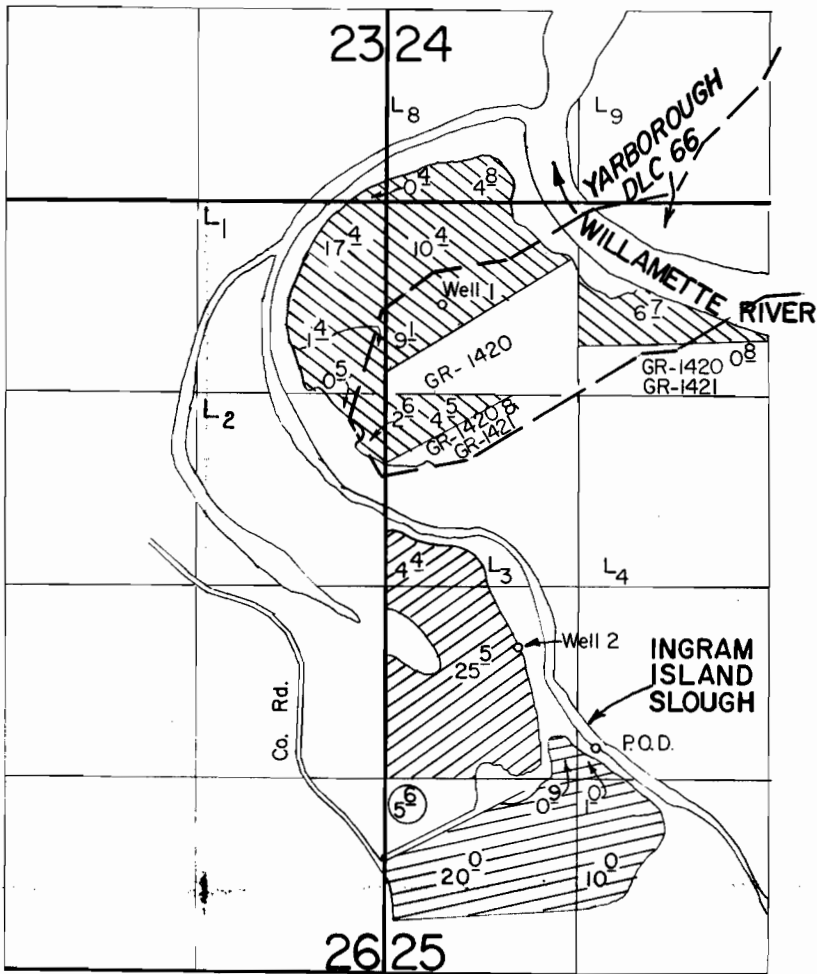

Well 1 Loc.: 700' S. & 390' E. from NW Cor. Sec. 25
 Well 2 Loc.: 410' S. & 920' E. from W. 1/4 Cor. Sec. 25
 P.O.D. Loc.: 1550' N. & 1450' E. from SW Cor. Sec. 25.

Scale: 1" = 1320'

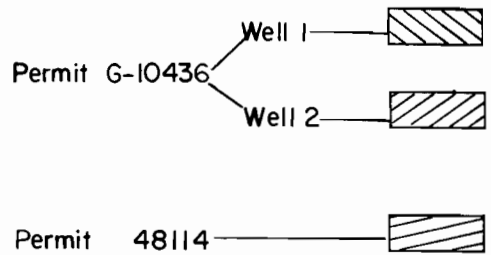

FINAL PROOF SURVEY

UNDER

Permit 48114

G-11186

G-10436

Application No. 67949... Permit No. 48114.....

IN NAME OF

DELBERT C. PITCHER

Surveyed Nov. 24, 1987, by T. Warren.....